Document 2008 106

Book 2008 Page 106 Type 06 043 Pages 1
Date 1/10/2008 Time 4:09 PM
Rec Amt $7.00

INDX ✓
ANNO
SCAN

LISA SMITH, COUNTY RECORDER
MADISON IOWA

CHEK

VANCE & HOCHSTETLER, P.C., CONSULTING ENGINEERS, WINTERSET, IOWA (515) 462-3995
CHARLES T. VANCE, 110 West Green St., Winterset, Iowa, 50273
JAMES M HOCHSTETLER, 110 West Green St., Winterset, Iowa 50273

07-1335

UNITED STATES PUBLIC LAND SURVEY CORNER CERTIFICATE OF


Land Survey Monuments situated in Section 3, Township 76N, Range 29W, of the Fifth Principal Meridian, MADISON County, Iowa.
Previously recorded in _____ in County Recorder's Office.
(book, page, document number, etc.)

(Show reason for preparing this certificate, the evidence and detailed procedures used in establishing the the corner positions and monumentation found or placed.)

Monument Description and Remarks: S¼ Cor - Calculated point which landed in pond based on found corners at W¼ Cor, center & E¼ Cor Sec 3; E¼ Cor, SE Cor, S¼ Cor, SW Cor & S W Cor NW¼ NW¼ Sec. 10; and S E Cor SW¼ SW¼ Sec 2 & limited physical evidence. Set witness corner 100.00' East on S. Line SE¼. SW Cor SE¼ SE¼ - Set yellow CIR #6808 at midpoint on line between Set S¼ Cor and calculated SE Cor. NW Cor. SE¼ SE¼ - Set yellow CIR #6808 at midpoint on line between set SW Cor SE¼ SE¼ & Calculated NW Cor NE¼ SE¼.

PLAN - VIEW

(Show a minimum of three reference ties to durable physical objects, relevant monuments and physical conditions that will enable recovery of the corner.)

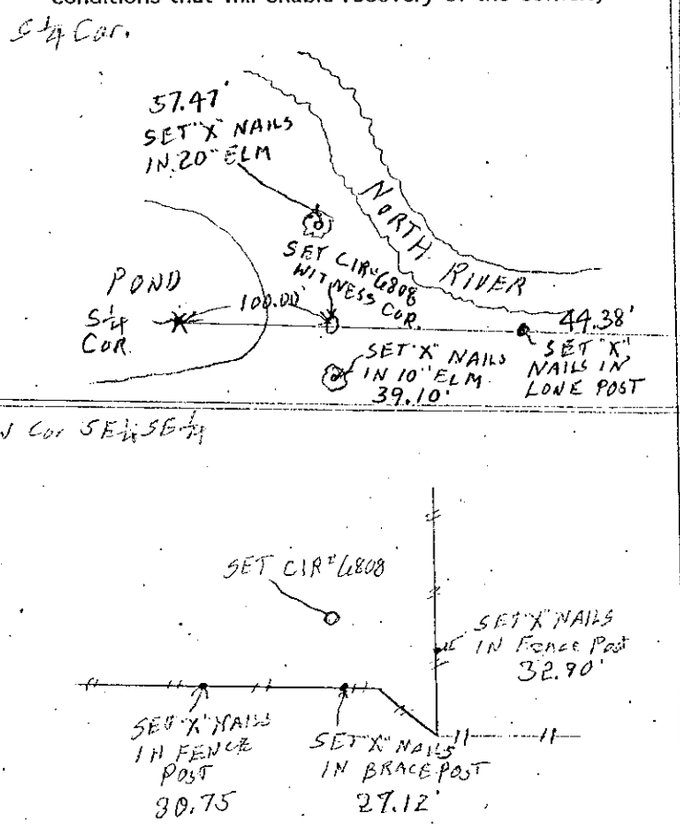

LICENSED LAND SURVEYOR
J. M. HOCHSTETLER
#6808
IOWA

I hereby certify that this land surveying document was prepared and the related survey work was performed by me or under my direct personal supervision and that I am a duly licensed Land Surveyor under the laws of the State of Iowa.

J.M. Hochstetler

J.M. HOCHSTETLER
License number 6808 Date 11/4/08
My license renewal date is December 31, 2009
Pages or sheets covered by this seal: 1

List Corners to be Indexed

Corners	Section	Twp	Range
S¼ Cor	3	76N	29W
SW COR SE¼ SE¼	3	76N	29W
NW Cor SE¼ SE¼	3	76N	29W