Document 2008 275

Book 2008 Page 275 Type 06 043 Pages 1
Date 1/25/2008 Time 12:46 PM
Rec Amt $7.00

INDX✓
ANNO
SCAN

LISA SMITH. COUNTY RECORDER
MADISON IOWA

CHEK

VANCE & HOCHSTETLER,P.C. CONSULTING ENGINEERS, WINTERSET, IOWA (515)462-3995
CHARLES T. VANCE, 110 WEST GREEN ST.,WINTERSET, IOWA 50273
JAMES M. HOCHSTETLER, 110 WEST GREEN ST., WINTERSET, IOWA 50273

UNITED STATES PUBLIC LAND SURVEY CORNER CERTIFICATE

OF


Land Survey Monuments situated in Section 27, Township 77 North, Range 27 West, of the Fifth Principal Meridian, Madison County, Iowa.
Previously recorded in N/A (book, page, document number, etc.) in County Recorder's Office.


(Show reason for preparing this certificate, the evidence and detailed procedures used in establishing the corner positions and monumentation found or placed.)

Monument Description and Remarks: Capped Iron Rods #5041 were set at all Corners. The Corner Locations were determined from Found Monuments and physical evidence at each site.

PLAN - VIEW


(Show a minimum of three reference ties to durable physical objects, relevant monuments and physical conditions that will enable recovery of the corner.)

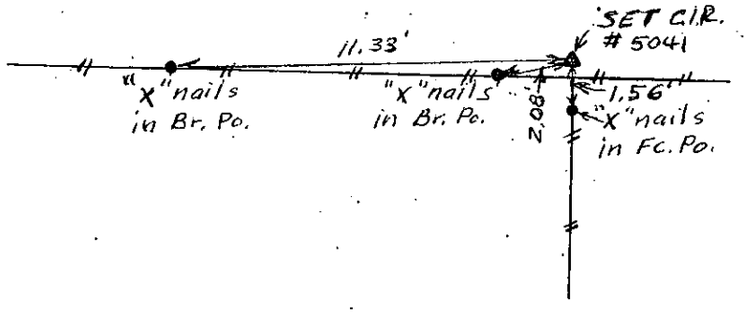

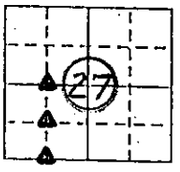


N

Ref. to NE. Cor. NW 1/4 SW 1/4 Sec. 27-77-27

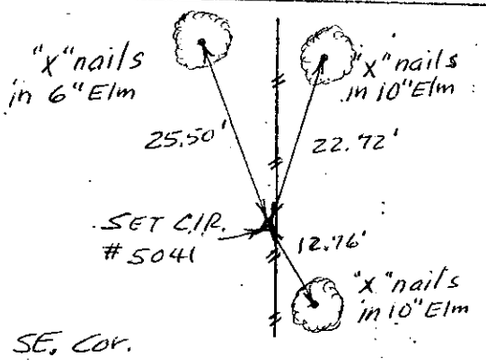

Ref. to SE. Cor.
NW. 1/4 SW. 1/4 Sec. 27-77-27

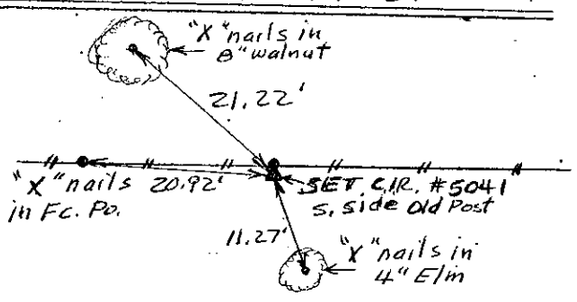

Ref. to SE. Cor.
SW. 1/4 SW 1/4 Sec. 27-77-27

I hereby certify that this land surveying document was prepared and the related survey work was preformed by me or under my direct personal supervision and that I am a duly Licensed Land Surveyor under the laws of the State of Iowa.

Charles T Vance 10 Jan. 2008
Charles T. Vance, PE & PLS — Date

License No. 5041

My License renewal date is 31, December 2009

List Corners to be Indexed

Corners	Section	Twp	Range
NE. Cor. NW. 1/4 SW 1/4	27	77	27
SE. Cor. NW. 1/4 SW. 1/4	27	77	27
SE. Cor. SW. 1/4 SW 1/4	27	77	27