Document 2008 315

Book 2008 Page 315 Type 06 043 Pages 1
Date 1/29/2008 Time 12:01 PM
Rec Amt $7.00

INDX ✓
ANNO
SCAN

LISA SMITH, COUNTY RECORDER
MADISON IOWA

CHEK

Jeffrey S. Hall Cornerstone Surveying, Inc. 9657 N. 99th Ave W Baxter, Iowa 50028 515-865-3155

UNITED STATES PUBLIC LAND SURVEY
CORNER CERTIFICATE OF

Land Survey monuments situated in Section 2, Township 77 North, Range 27 West of the Fifth Principal Meridian, Madison County, Iowa.

Previously recorded in N/A in the County Recorder's Office

Monument Description and Remarks:

THESE CORNERS WERE UTLIZED IN A SURVEY OF THE SE1/4 SW1/4. THIS CERTIFICATE WAS PREPARED DUE TO NO CERTIFICATES OF RECORD.


S1/4 CORNER - FND 1/2" REBAR (6" DEEP) AS SHOWN IN COUNTY ENGINEERS TIES

NE COR., SE1/4 SW1/4 - NO RECORD OF THIS CORNER EVER BEING SET. LISTENED W/ LOCATOR BUT FOUND NOTHING. SET 5/8"x24" REBAR W/ YELLOW PLASTIC CAP #17342 (3" DEEP) ON LINE AND AT THE MID POINT BETWEEN THE S1/4 CORNER AND THE CENTER OF SECTION. THIS POSITION IS APPROX. 4' SOUTH OF FENCELINES EAST & WEST AND 3' EAST OF CL ROAD.


LEGEND
YPC = YELLOW PLASTIC CAP

PLAN VIEW
(NOT TO SCALE)

*ALL DISTANCES ARE HORIZONTALLY MEASURED

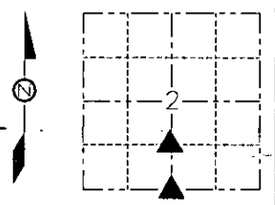


S1/4 CORNER

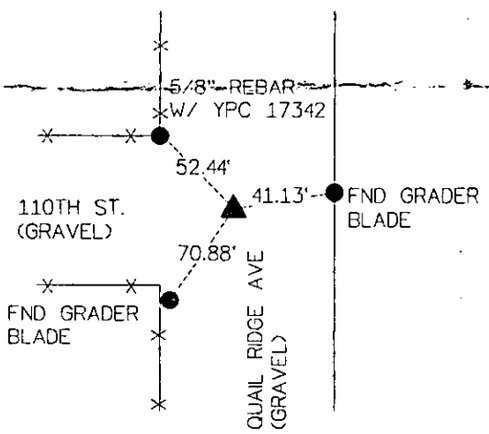

*THIS MONUMENT WAS IN THE APPROX CL OF N-S & E-W ROAD

NE CORNER SE1/4 SW1/4

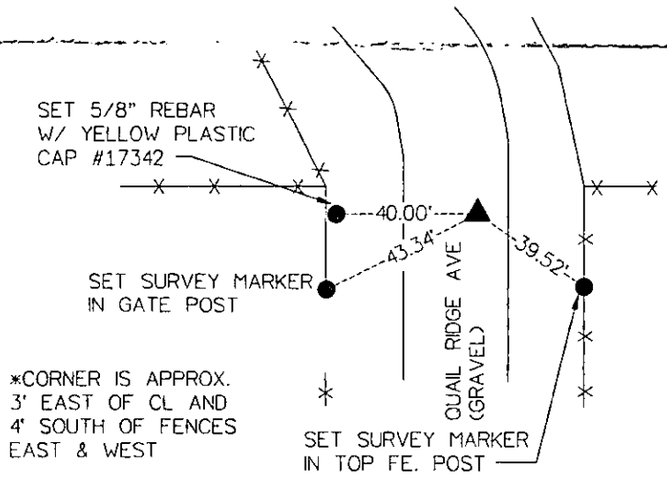

*CORNER IS APPROX. 3' EAST OF CL AND 4' SOUTH OF FENCES EAST & WEST


I HEREBY CERTIFY THAT THIS LAND SURVEYING DOCUMENT WAS PREPARED AND THE RELATED SURVEY WORK WAS PERFORMED BY ME OR UNDER MY DIRECT PERSONAL SUPERVISION AND THAT I AM A DULY LICENSED LAND SURVEYOR UNDER THE LAWS OF THE STATE OF IOWA.

Jeffrey S. Hall — 12/28/2007
Jeffrey S. Hall — Date

IOWA LICENSE NUMBER 17342

MY LICENSE RENEWAL DATE IS DECEMBER 31, 2008

PAGES OR SHEETS COVERED BY THIS SEAL: 1 OF 1

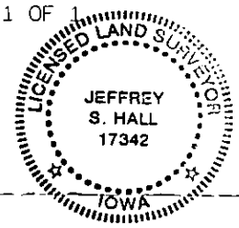

CORNERS TO BE INDEXED

Corner	Section	Township	Range
S1/4 CORNER	2	77	27
NE COR. SE1/4 SW1/4	2	77	27

Cornerstone Surveying, Inc.
515-865-3155
WWW.IACORNERSTONE.COM
9657 N. 99TH AVE W. BAXTER, IA 50028