Document 2008 365

Book 2008 Page 365 Type 06 043 Pages 1
Date 2/01/2008 Time 3:38 PM
Rec Amt $7.00

INDX ✓
ANNO
SCAN

LISA SMITH. COUNTY RECORDER
MADISON IOWA

CHEK

VANCE & HOCHSTETLER, P.C., CONSULTING ENGINEERS, WINTERSET, IOWA (515) 462-3995
CHARLES T. VANCE, 110 West Green St., Winterset, Iowa, 50273
JAMES M HOCHSTETLER, 110 West Green St., Winterset, Iowa 50273

UNITED STATES PUBLIC LAND SURVEY CORNER CERTIFICATE

OF


Land Survey Monuments situated in Section 9, Township 74 N, Range 28 W, of the Fifth Principal Meridian, MADISON County, Iowa.
Previously recorded in _____ in County Recorder's Office.
(book, page, document number, etc.)

(Show reason for preparing this certificate, the evidence and detailed procedures used in establishing the the corner positions and monumentation found or placed.)
Monument Description and Remarks: NW COR. - Set yellow CIR #6808 exposed. We found a stone at this corner a number of years ago and set a CIR over the stone but a new fence has recently been installed to the South. It appears that they dozed out the old corner and set new corner posts at the same site based on present fence lines. We feel that the new CIR #6808 set is very close to where the stone was.

PLAN - VIEW

(Show a minimum of three reference ties to durable physical objects, relevant monuments and physical conditions that will enable recovery of the corner.)

NW COR.

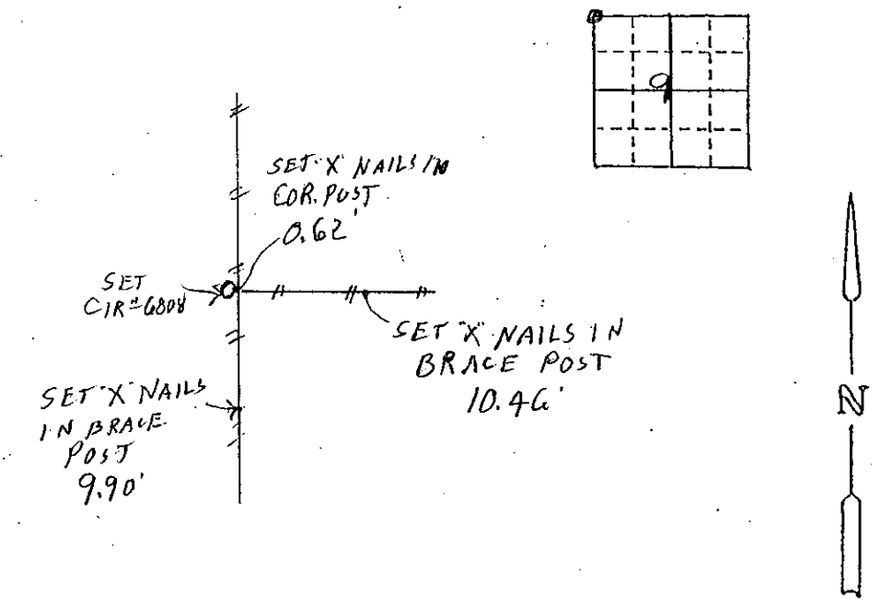

LICENSED LAND SURVEYOR
J. M. HOCHSTETLER #6808
IOWA

I hereby certify that this land surveying document was prepared and the related survey work was performed by me or under my direct personal supervision and that I am a duly licensed Land Surveyor under the laws of the State of Iowa.

J.M. Hochstetler
J.M. HOCHSTETLER
License number 6808 Date 1/31/08
My license renewal date is December 31 2009
Pages or sheets covered by this seal: 1

List Corners to be Indexed

Corners	Section	Twp	Range
NW COR	9	74N	28W