Document 2008 1264

Book 2008 Page 1264 Type 06 043 Pages 1
Date 4/22/2008 Time 9:25 AM
Rec Amt $7.00

INDX ✓
ANNO
SCAN

LISA SMITH, COUNTY RECORDER
MADISON IOWA

CHEK

VANCE & HOCHSTETLER, P.C., CONSULTING ENGINEERS, WINTERSET, IOWA (515) 462-3995
CHARLES T. VANCE, 110 West Green St., Winterset, Iowa, 50273
JAMES M HOCHSTETLER, 110 West Green St., Winterset, Iowa 50273

UNITED STATES PUBLIC LAND SURVEY CORNER CERTIFICATE

8-363

OF

Land Survey Monuments situated in Section 15, Township 74 NORTH, Range 27 WEST, of the Fifth Principal Meridian, MADISON County, Iowa.
Previously recorded in _____ in County Recorder's Office.
(book, page, document number, etc.)

(Show reason for preparing this certificate, the evidence and detailed procedures used in establishing the the corner positions and monumentation found or placed.)

Monument Description and Remarks:

SW cor NW.1/4 SE.1/4 - Set Capped Iron Rod #6808 (1/2" rebar, exposed) at existing 2-way fence corner


SE cor NW.1/4 SE.1/4 - Set C.I.R. #6808 (1/2" rebar, exposed) at existing 3-way fence corner

NE cor. NW.1/4 SE.1/4 - Set C.I.R. #6808 (1/2" rebar, exposed) at existing 3-way fc. corner at approximate split of driveway fences going West towards county road.


PLAN - VIEW

(Show a minimum of three reference ties to durable physical objects, relevant monuments and physical conditions that will enable recovery of the corner.)


SW CORNER
NW.1/4 SE.1/4
SEC. 15-74-27
Set C.I.R. #6808

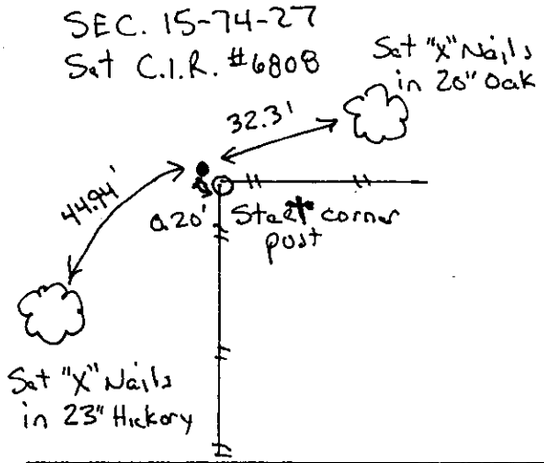

SE CORNER
NW.1/4 SE.1/4
SEC. 15-74-27
Set C.I.R. #6808

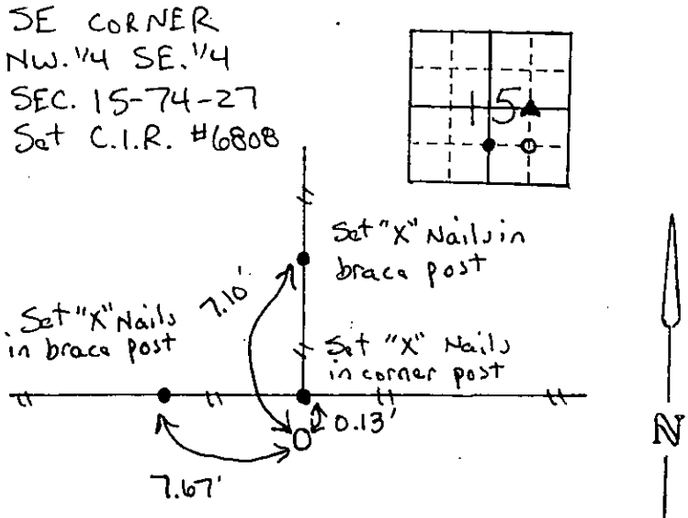

NE CORNER
NW.1/4 SE.1/4
SEC. 15-74-27
Set C.I.R. #6808

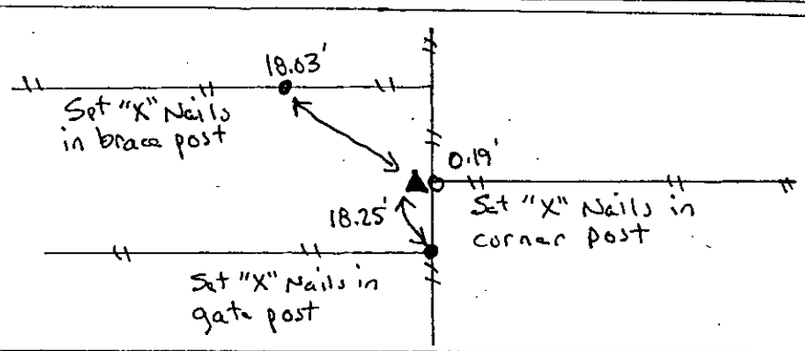

LICENSED LAND SURVEYOR
J. M. HOCHSTETLER
#6808
IOWA

I hereby certify that this land surveying document was prepared and the related survey work was performed by me or under my direct personal supervision and that I am a duly licensed Land Surveyor under the laws of the State of Iowa.

J.M. HOCHSTETLER
License number 6808 Date 4/16/08.
My license renewal date is December 31, 2009
Pages or sheets covered by this seal: 1

List Corners to be Indexed

Corners	Section	Twp	Range
SW cor NW.1/4 SE.1/4	15	74N	27W
SE cor NW.1/4 SE.1/4	15	74N	27W
NE cor. NW.1/4 SE.1/4	15	74N	27W