Document 2008 1075
Book 2008 Page 1075 Type 06 043 Pages 1
Date 4/03/2008 Time 12:12 PM
Rec Amt $7.00
INDX
ANNO
SCAN
LISA SMITH, COUNTY RECORDER
MADISON IOWA
CHEK

HACKETT SURVEYING, Prepared By: Michael James Hackett, 712 North 9th. Ave., Winterset, Ia. 50273, Tel. (515) 462-1106

UNITED STATES PUBLIC LAND SURVEY CORNER CERTIFICATE OF


Land Survey Monuments situated in Section 18, Township 75 N, Range 27 W, of the Fifth Principal Meridian, Madison County, Iowa.
Previously recorded in _____ in County Recorder's Office.
(book, page, document number, etc.)

(Show reason for preparing this certificate, the evidence and detailed procedures used in establishing the corner positions and monumentation found or placed.)


Monument Description and Remarks: Searched with metal locator and probed for corner with nothing found. Set 5/8" x 18" rebar with red plastic cap, PLS #14672. Traversed the section to gather information and calculate the position of the corner. The position of the corner is based on calculating the intersection of a east – west line from the found southwest corner of the Northeast Quarter of the Southwest Quarter to the calculated point of the southeast corner of the Northeast Quarter of the Southeast Quarter and a north – south line from the found northeast corner of the Southwest Quarter of the Northeast Quarter to the calculated point of the southwest corner of the Southeast Quarter of the Southeast Quarter.

PLAN VIEW

(Show a minimum of three reference ties to durable physical objects, relevant monuments and physical conditions that will enable recovery of the corner.)

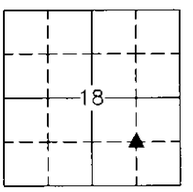


SET 5/8" x 18" REBAR
WITH RED PLASTIC CAP,
PLS #14672.

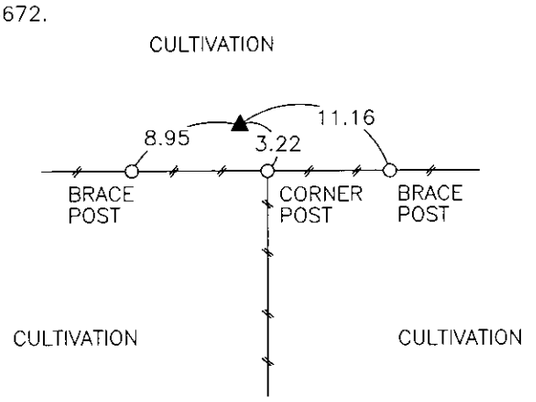



SE. COR., NW. 1/4, SE. 1/4, SEC. 18

NOTE: ALL TIES TO "X" NAILS UNLESS NOTED

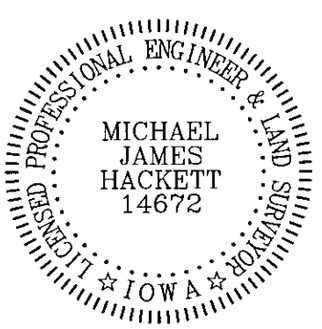

I hereby certify that this land surveying document was prepared and the related survey work was performed by me or under my direct personal supervision and that I am a duly Licensed Land Surveyor under the laws of the State of Iowa.

Signed _____ Date 3-28-2008
Michael James Hackett

Iowa license number 14672.
My license renewal date is 12/31/2008.
Pages covered by this seal: 1.

22-08-3