

HACKETT SURVEYING, Prepared By: Michael James Hackett, 712 North 9th. Ave., Winterset, Ia. 50273, Tel. (515) 462-1106

UNITED STATES PUBLIC LAND SURVEY CORNER CERTIFICATE
OF

Land Survey Monuments situated in Section 18, Township 75 N, Range 27 W, of the Fifth Principal Meridian, Madison County, Iowa.
Previously recorded in _____ in County Recorder's Office.
(book, page, document number, etc.)

(Show reason for preparing this certificate, the evidence and detailed procedures used in establishing the corner positions and monumentation found or placed.)



Monument Description and Remarks: Found iron pin with yellow plastic cap, cap not readable, in fence line.
Traversed the section to confirm location of corner. Accepted position. The reason for preparing this certificate
is that there is no previous ties on file.

_____ northeast corner of the Southeast Quarter of the Northwest Quarter to the calculated point of the southwest corner

PLAN VIEW


(Show a minimum of three reference ties to durable physical objects, relevant monuments and physical conditions that will enable recovery of the corner.)

FOUND IRON PIN WITH
YELLOW PLASTIC CAP,
CAP NOT READABLE.

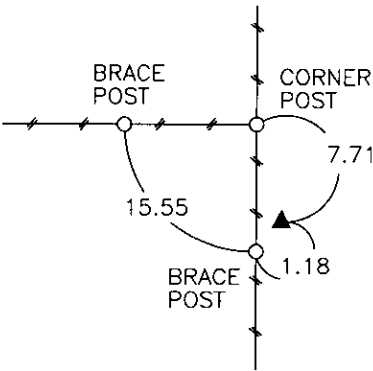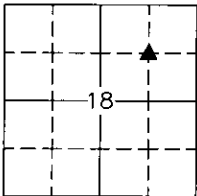

NE. COR., SW. 1/4, NE. 1/4, SEC. 18

NOTE: ALL TIES TO "X" NAILS UNLESS NOTED

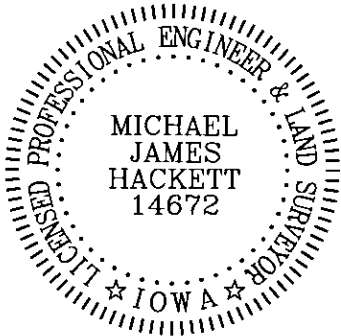

I hereby certify that this land surveying document was prepared and the related survey work was performed by me or under my direct personal supervision and that I am a duly Licensed Land Surveyor under the laws of the State of Iowa.

Signed Michael James Hackett Date 3-28-2008
Michael James Hackett
Iowa license number 14672.
My license renewal date is 12/31/2008.
Pages covered by this seal: 1.