Document 2008 1860

Book 2008 Page 1860 Type 06 043 Pages 1
Date 6/12/2008 Time 10:16 AM
Rec Amt $7.00

INDX ✓
ANNO
SCAN

LISA SMITH. COUNTY RECORDER
MADISON IOWA

CHEK

Prepared by: Boldman Surveying Consultants, 521 West Green St. Winterset, Ia. 50273 Ph 515-462-9242

UNITED STATES PUBLIC LAND SURVEY CORNER CERTIFICATE

OF


Land Survey Monuments situated in Section 5, Township 74, Range 28, of the Fifth Principal Meridian, Madison County, Iowa
Previously recorded in Were found in County Recorder's Office.
(book, page, document number, etc.)


(show reason for preparing this certificate, the evidence and detailed procedures used in establishing the corner positions and monumentation found or placed.)

Monument Description and Remarks: NW cor - NE¼ NW¼ - Fd. pin & cap #5041 at intersection of county road North and East-West county road.
All tied to pk nail and orange washer (NAW) unless noted otherwise

PLAN-VIEW

(Show a minimum of three reference ties to durable physical objects, relevant monuments and physical conditions that will enable recovery of the corner.)

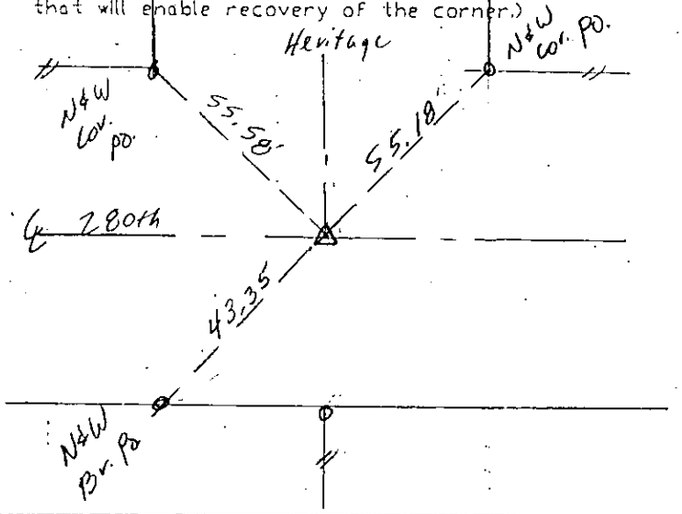

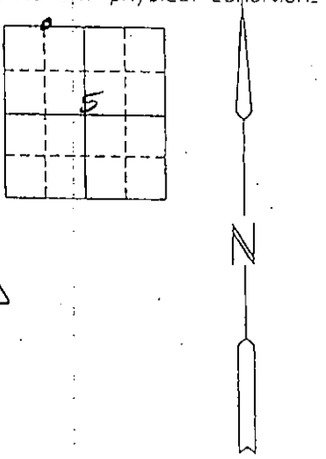


I hereby certify that the survey work was completed and this certificate was prepared by me or under my direct personal supervision and that I am a duly Licensed Land Surveyor under the laws of the State of Iowa

Signature: Craig S. Boldman

Date: 5/19/08 Reg. No. 13427

SEAL

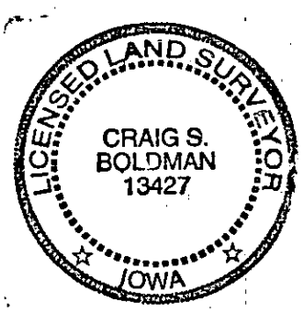

List Corners to be Indexed

Corners	Section	Twp	Range
NW cor NE¼ NW¼	5	74	28

Job # 08020