Document 2008 1352

Book 2008 Page 1352 Type 06 043 Pages 1
Date 4/28/2008 Time 3:37 PM
Rec Amt $7.00

INDX ✓
ANNO
SCAN

LISA SMITH. COUNTY RECORDER
MADISON IOWA

CHEK

VANCE & HOCHSTETLER,P.C. CONSULTING ENGINEERS, WINTERSET, IOWA (515)462-3995
08-28s CHARLES T. VANCE, 110 WEST GREEN ST.,WINTERSET, IOWA 50273
JAMES M. HOCHSTETLER, 110 WEST GREEN ST., WINTERSET, IOWA 50273

UNITED STATES PUBLIC LAND SURVEY CORNER CERTIFICATE

OF


Land Survey Monuments situated in Section 13, Township 74 North, Range 29 West, of the Fifth Principal Meridian, Madison County, Iowa.
Previously recorded in N/A in County Recorder's Office.
(book, page, document number, etc.)


(Show reason for preparing this certificate, the evidence and detailed procedures used in establishing the corner positions and monumentation found or placed.)


Monument Description and Remarks: NW. Cor. SW¼-NW¼, Found C.I.R. #7044 on Section line and on line with property fence to the East. NE. Cor. SW.¼ NW.¼, Set C.I.R. at Corner Post on N-S property line fence and property line fence to the West.

PLAN - VIEW


(Show a minimum of three reference ties to durable physical objects, relevant monuments and physical conditions that will enable recovery of the corner.)

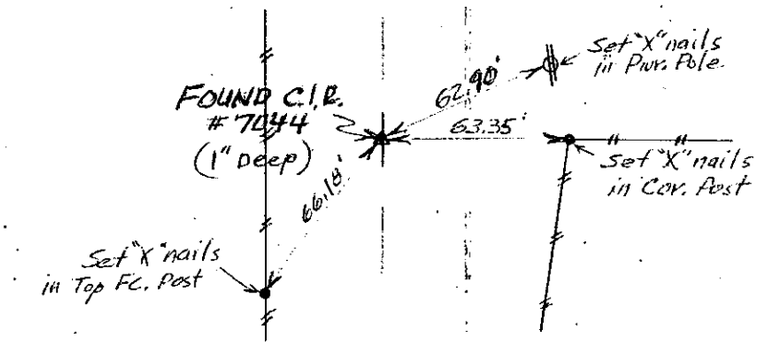

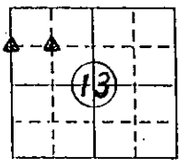

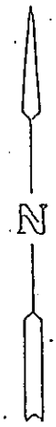

Ref. to NW. Cor., SW¼-NW¼ Sec. 13, T74N, R29W

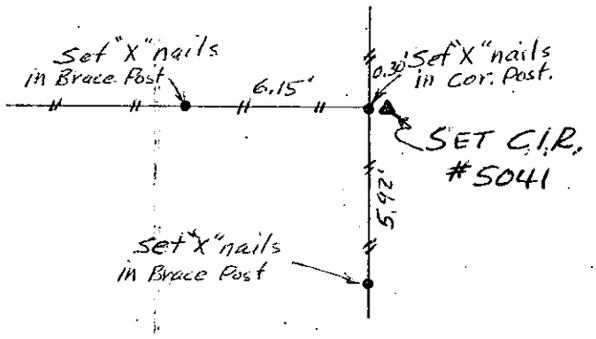

Ref. to NE. Cor., SW.¼ SW.¼ Sec. 13, T74N, R29W

I hereby certify that this land surveying document was prepared and the related survey work was preformed by me or under my direct personal supervision and that I am a duly Licensed Land Surveyor under the laws of the State of Iowa.

Charles T Vance 25 April 2008
Charles T. Vance, PE & PLS Date

License No. 5041

My License renewal date is 31, December 2009

List Corners to be Indexed

Corners	Section	Twp	Range
NW. Cor. SW.¼ NW.¼	13	T74N	R29W
NE. Cor. SW¼ NW.¼	13	T74N	R29W