Document 2008 1540

Book 2008 Page 1540 Type 06 043 Pages 1
Date 5/12/2008 Time 2:11 PM
Rec Amt $7.00

INDX V
ANNO
SCAN

LISA SMITH. COUNTY RECORDER
MADISON IOWA

CHEK

VANCE & HOCHSTETLER, P.C., CONSULTING ENGINEERS, WINTERSET, IOWA (515) 462-3995
CHARLES T. VANCE, 110 West Green St., Winterset, Iowa, 50273
JAMES M HOCHSTETLER, 110 West Green St., Winterset, Iowa 50273

08-25s

UNITED STATES PUBLIC LAND SURVEY CORNER CERTIFICATE


OF

Land Survey Monuments situated in Section 13, Township 77 N, Range 28 W, of the Fifth Principal Meridian, MADISON County, Iowa.
Previously recorded in _____ in County Recorder's Office.
(book, page, document number, etc.)

(Show reason for preparing this certificate, the evidence and detailed procedures used in establishing the the corner positions and monumentation found or placed.)
Monument Description and Remarks: Center - Set yellow CIR #6808 at old existing three-way property line fence intersection. Point is 3.90' North of line between found SW Cor SE¼ NW¼ & SE Cor SW¼ NE¼. EAST ¼ COR - Set yellow CIR #6808 at intersection of line from set Center through found S.E. Cor SW¼ NW¼ with line from found NE Cor. to S E Cor. SE COR NE¼ SE¼ - Set yellow CIR #6808 on line between set E¼ Cor and found S.E. COR. at intersection with old property line fence.

PLAN - VIEW

(Show a minimum of three reference ties to durable physical objects, relevant monuments and physical conditions that will enable recovery of the corner.)

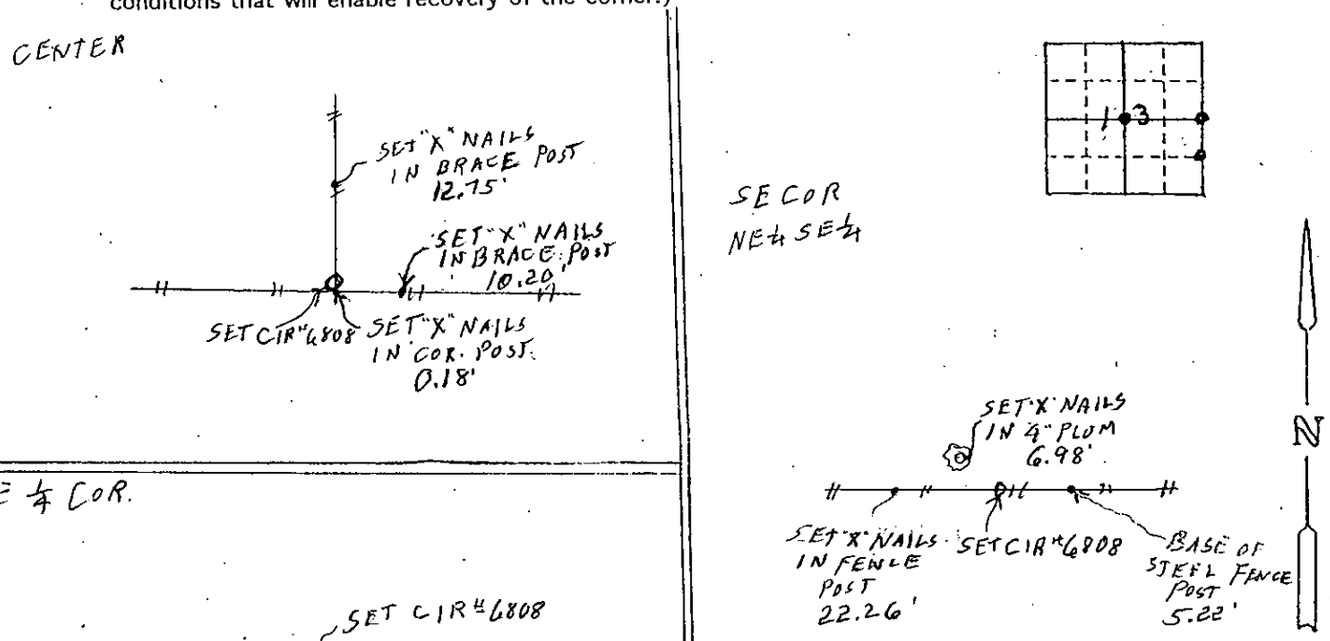

LICENSED LAND SURVEYOR
J. M. HOCHSTETLER #6808
IOWA

I hereby certify that this land surveying document was prepared and the related survey work was performed by me or under my direct personal supervision and that I am a duly licensed Land Surveyor under the laws of the State of Iowa.

J.M. HOCHSTETLER
License number 6808 Date 5/6/08
My license renewal date is December 31 2009
Pages or sheets covered by this seal:

List Corners to be Indexed

Corners	Section	Twp	Range
CENTER	13	77	28
E¼ COR	13	77	28
SE COR NE¼ SE¼	13	77	28