Document 2008 1541

Book 2008 Page 1541 Type 06 043 Pages 1
Date 5/12/2008 Time 2:14 PM
Rec Amt $7.00

INDX
ANNO
SCAN

LISA SMITH, COUNTY RECORDER
MADISON IOWA

CHEK

VANCE & HOCHSTETLER, P.C., CONSULTING ENGINEERS, WINTERSET, IOWA (515) 462-3995
CHARLES T. VANCE, 110 West Green St., Winterset, Iowa, 50273
JAMES M HOCHSTETLER, 110 West Green St., Winterset, Iowa 50273

08-25s

UNITED STATES PUBLIC LAND SURVEY CORNER CERTIFICATE

OF

Land Survey Monuments situated in Section 18, Township 77 N, Range 27, of the Fifth Principal Meridian, MADISON County, Iowa.


Previously recorded in _____ in County Recorder's Office.
(book, page, document number, etc.)

(Show reason for preparing this certificate, the evidence and detailed procedures used in establishing the the corner positions and monumentation found or placed.)

Monument Description and Remarks: N¼ COR - Set yellow CIR "6808 3" deep in ℄ County Road in line with old property line fence to South. CENTER - Set yellow CIR "6808 at 4 Way property Line fence Corner. SW COR SE¼ NW¼ - Set yellow CIR "6808 on line between set Center and set W¼ Cor in line with old property line fence to South. SE COR NWFr¼ SW¼ - Set yellow CIR "6808 at old three-way property line fence Corner.

PLAN - VIEW

(Show a minimum of three reference ties to durable physical objects, relevant monuments and physical conditions that will enable recovery of the corner.)

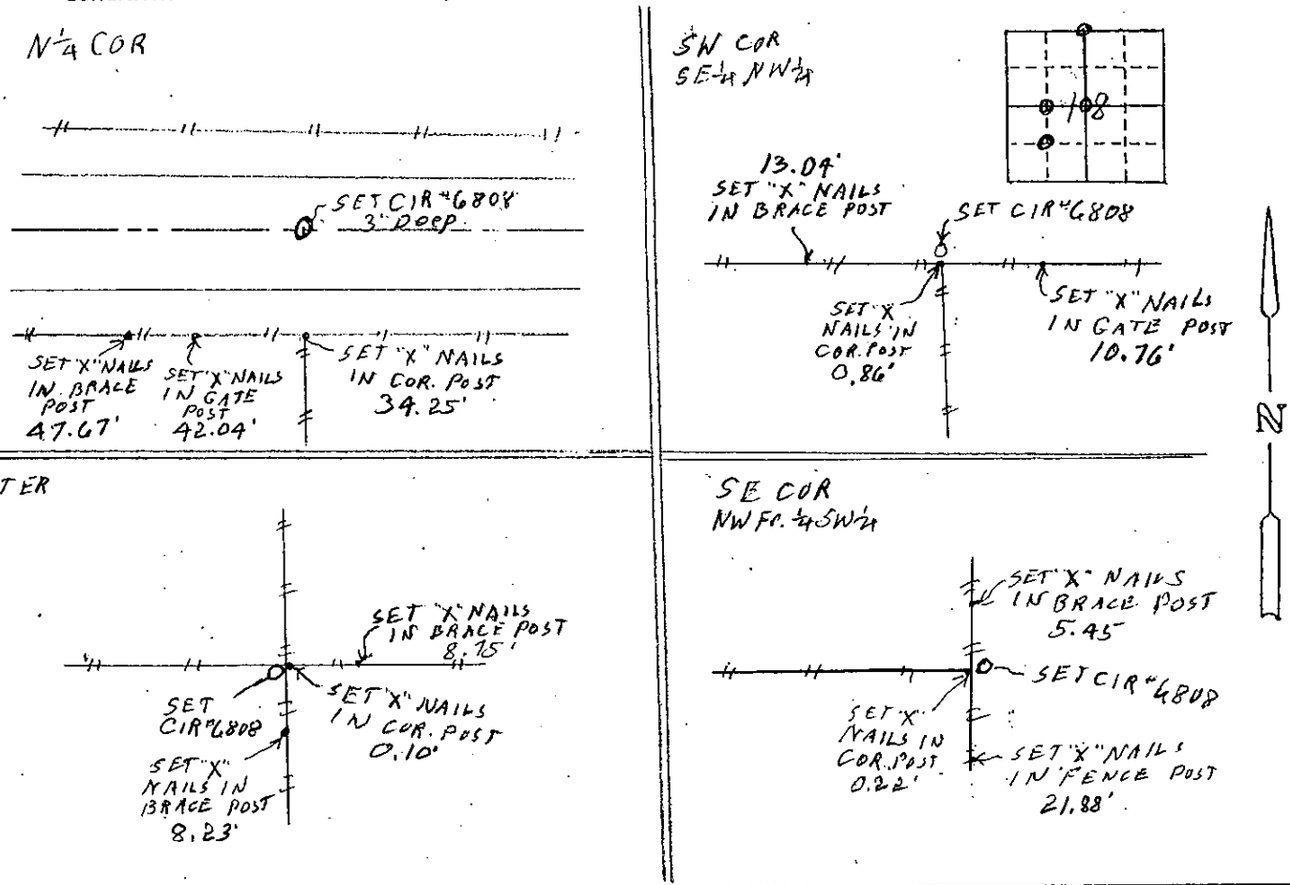

LICENSED LAND SURVEYOR
J. M. HOCHSTETLER
#6808
IOWA

I hereby certify that this land surveying document was prepared and the related survey work was performed by me or under my direct personal supervision and that I am a duly licensed Land Surveyor under the laws of the State of Iowa.

J.M. Hochstetler
J.M. HOCHSTETLER
License number 6808 Date 5/6/08
My license renewal date is December 31, 2009
Pages or sheets covered by this seal: 1

List Corners to be Indexed

Corners	Section	Twp	Range
N¼ Cor	18	77	27
CENTER	18	77	27
SW COR SE¼ NW¼	18	77	27
SE COR NWFr¼ SW¼	18	77	27