

LISA SMITH, COUNTY RECORDER
MADISON IOWA

REAL ESTATE TRANSFER - GROUNDWATER HAZARD STATEMENT
TO BE COMPLETED BY TRANSFEROR

TRANSFEROR

Name Mark A. Wishman

Address 3052 Ivy Trail, Lorimor, IA 50149

Number and Street or RR

City, Town or P.O.

State

Zip

TRANSFeree

Name Kyle J. Lauer and Dawn M. Lauer

Address 3027 Carver Road, Winterset, IA 50273

Number and Street or RR

City, Town or P.O.

State

Zip

Address of Property Transferred 3052 Ivy Trail, Lorimor, IA 50149

Number and Street or RR

City, Town, or P.O.

State

Zip

Legal Description of Property See 1 in Addendum

1. Wells (check one)

There are no known wells situated on this property.

There is a well or wells situated on this property. The type(s), location(s) and legal status are stated below.

2. Solid Waste Disposal (check one)

There is no known solid waste disposal site on this property.

There is a solid waste disposal site on this property, but no notice has been received from the Department of Natural Resources that the site is deemed to be potentially hazardous.

There is a solid waste disposal site on this property which has been deemed to be potentially hazardous by the Department of Natural Resources. The location(s) of the site(s) is stated below.

3. Hazardous Wastes (check one)

There is no known hazardous waste on this property.

There is hazardous waste on this property and it is being managed in accordance with Department of Natural Resources rules.

4. Underground Storage Tanks (check one)

There are no known underground storage tanks on this property. (Note exclusions such as small farm and residential motor fuel tanks, most heating oil tanks, cisterns and septic tanks, in instructions.)

There is an underground storage tank on this property. The type(s), size(s) and any known substance(s) contained are listed below.

5. Private Burial Site (check one)

There are no known private burial sites on this property.

There is a private burial site on this property. The location(s) of the site(s) is stated below. The known identifying information of the decedent is stated below.

Information, if any, required by statements checked above shall be provided on a separate sheet attached hereto:

I HEREBY DECLARE THAT I HAVE REVIEWED THE INSTRUCTIONS FOR THIS FORM
AND THAT THE INFORMATION STATED ABOVE IS TRUE AND CORRECT.

Signature: Mark A. Wishman

(Transferor or Agent)


Telephone Number: 815 462-3120

Addendum

1. Parcel "A" located in the Northeast Quarter (NE 1/4) of the Southwest Quarter (SW 1/4) of Section Sixteen (16), Township Seventy-four (74) North, Range Twenty-eight (28) West of the 5th P.M., Madison County, Iowa, as shown in Plat of Survey filed in Book 3, Page 417, on March 31, 1999, in the Office of the Recorder of Madison County, Iowa.

Additional Groundwater Hazard Information

North

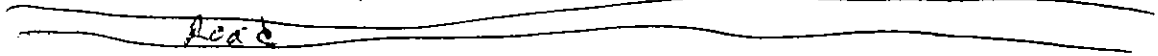

1. Wells:

Owell

house

2. Solid Waste:

3. Hazardous Waste:

4. Underground Storage Tanks:

5. Private Burial Sites:

Other information: