
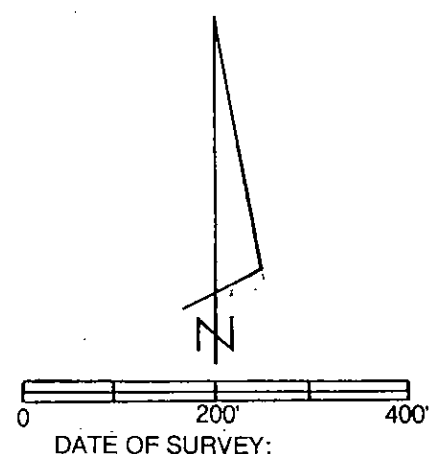


LISA SMITH, COUNTY RECORDER  
MADISON IOWA

DB-705 VANCE & HOCHSTETLER, P.C. • CONSULTING ENGINEERS • WINTERSET, IOWA • 50273

CHARLES T. VANCE • 110 WEST GREEN ST., WINTERSET, IOWA • (515) 462-3995  
JAMES M HOCHSTETLER • 110 WEST GREEN ST., WINTERSET, IOWA • FAX: (515) 462 9845

PROPERTY LINE RETRACEMENT SURVEY OF THE NORTHWEST  
QUARTER OF THE SOUTHWEST QUARTER OF THE NORTHEAST QUARTER OF  
SECTION 1, TOWNSHIP 74 NORTH, RANGE 26 WEST OF THE 5<sup>TH</sup> P.M.,  
MADISON COUNTY, IOWA OWNED BY ARTHUR A. SMITH.

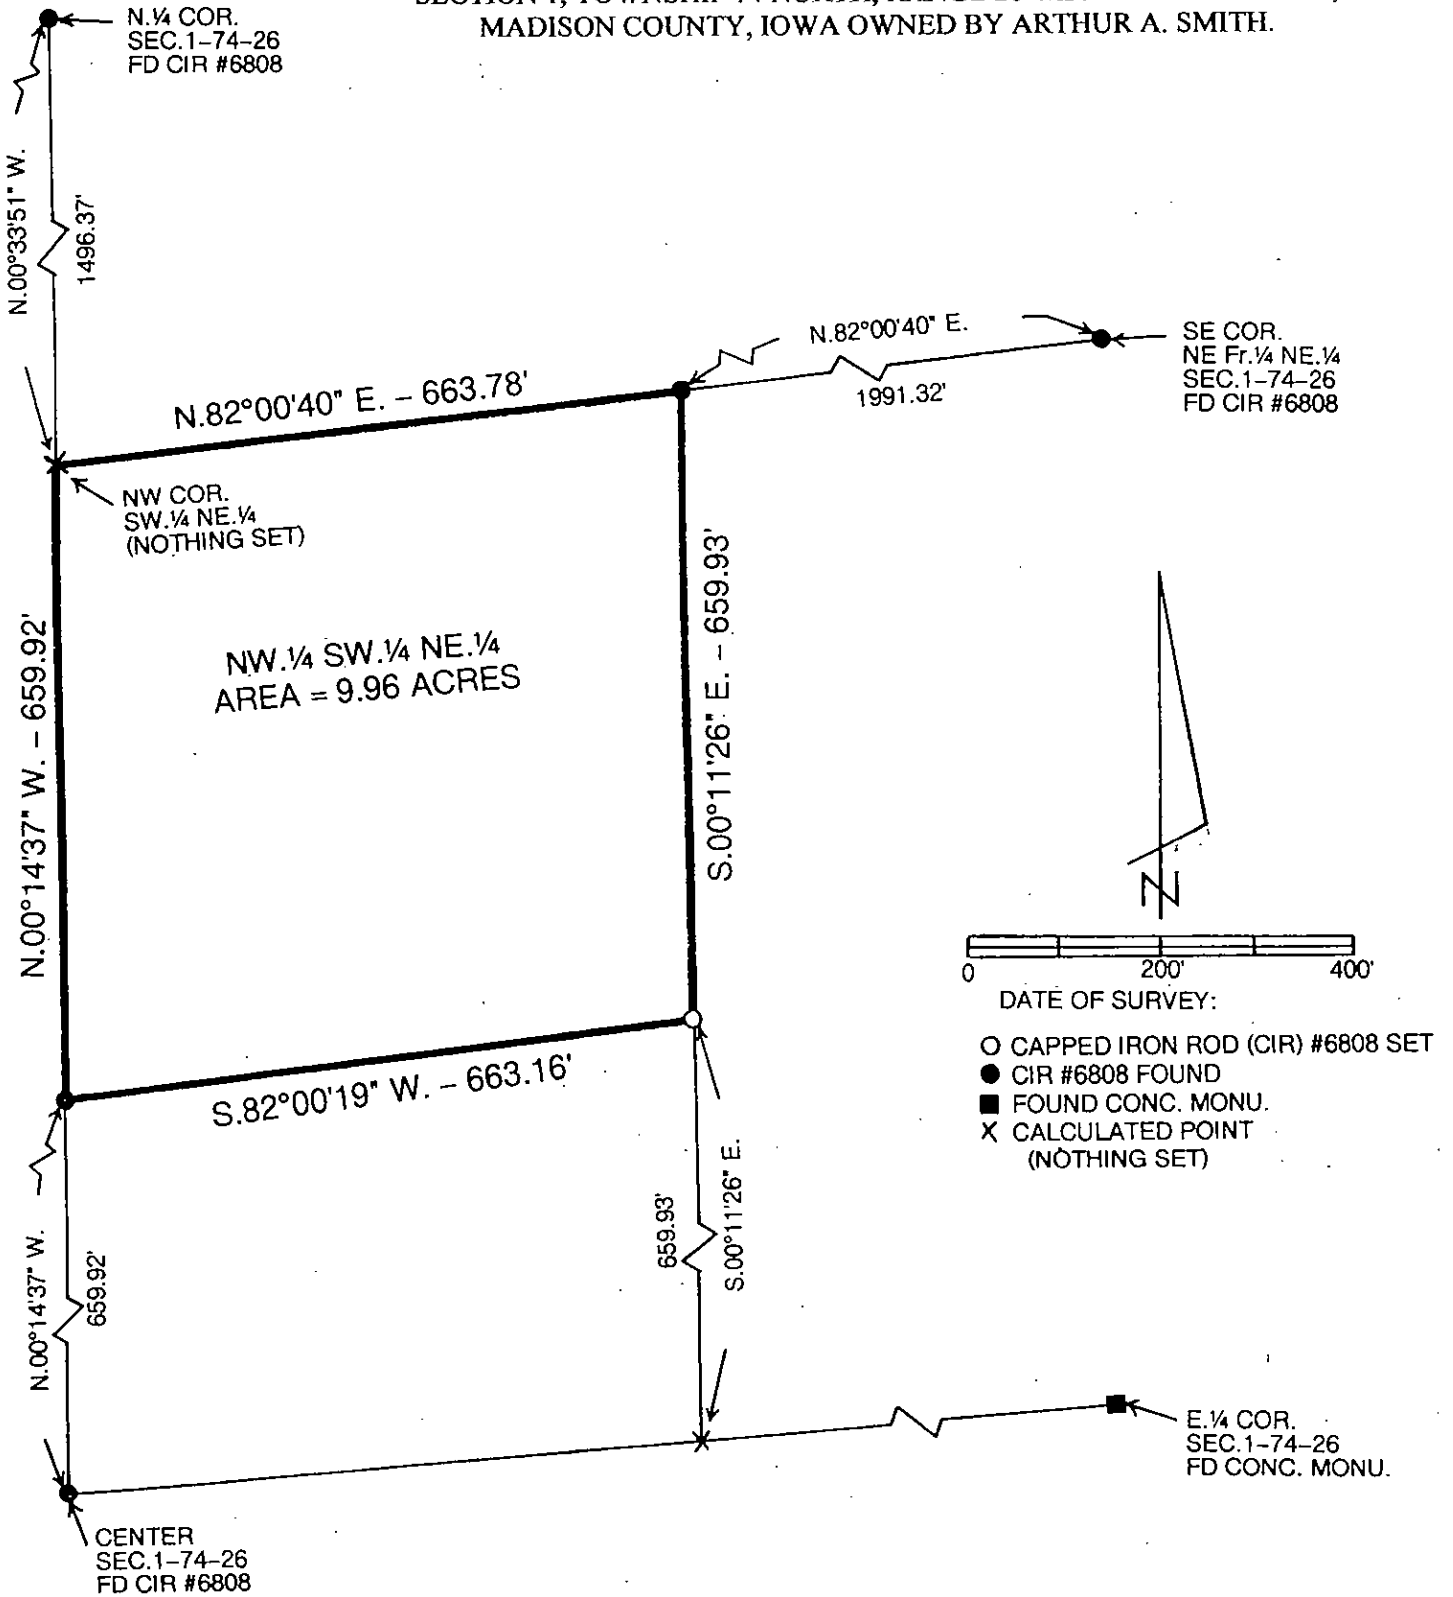

LEGAL DESCRIPTION:

The Northwest Quarter of the Southwest  
Quarter of the Northeast Quarter of Section 1,  
Township 74 North, Range 26 West of the 5<sup>th</sup> P.M.,  
Madison County, Iowa containing 9.96 acres.

I hereby certify that this land surveying document was prepared and the related survey work was performed by me or under my direct personal supervision and that I am a duly licensed Land Surveyor under the laws of the State of Iowa.

*J.M. Hochstetler*  
J.M. HOCHSTETLER  
#6808

License number 6808 Date 7/23/08  
My license renewal date is December 31, 2009  
Pages or sheets covered by this seal: 1