Document 2008 2000
Book 2008 Page 2000 Type 06 043 Pages 1
Date 6/23/2008 Time 2:50 PM
Rec Amt $7.00
INDX ✓
ANNO
SCAN
LISA SMITH, COUNTY RECORDER
MADISON IOWA
CHEK

HACKETT SURVEYING, Prepared By: Michael James Hackett, 712 North 9th. Ave., Winterset, Ia. 50273, Tel. (515) 462-1106

UNITED STATES PUBLIC LAND SURVEY CORNER CERTIFICATE OF


Land Survey Monuments situated in Section 18, Township 75 N, Range 29 W, of the Fifth Principal Meridian, Madison County,Iowa.
Previously recorded in _____ in County Recorder's Office.
(book, page, document number,etc.)

(Show reason for preparing this certificate, the evidence and detailed procedures used in establishing the corner positions and monumentation found or placed.)

Monument Description and Remarks: Found iron rail road spike. Verified the position by traversing the Southeast Quarter. The position reasonably concurs with the field evidence of the road that runs along the east side of the Southeast Quarter and the existing fences that run along the north side of the Southeast Quarter. The existing fence evidence reasonably concurs with a plat of survey dated May 10, 1876, on file in Book 2, Page 239, Madison County Engineers Office. The road evidence concurs with the road record, that the road runs on section line, the road record is on file at the Madison County Engineers Office.

PLAN VIEW

(Show a minimum of three reference ties to durable physical objects, relevant monuments and physical conditions that will enable recovery of the corner.)

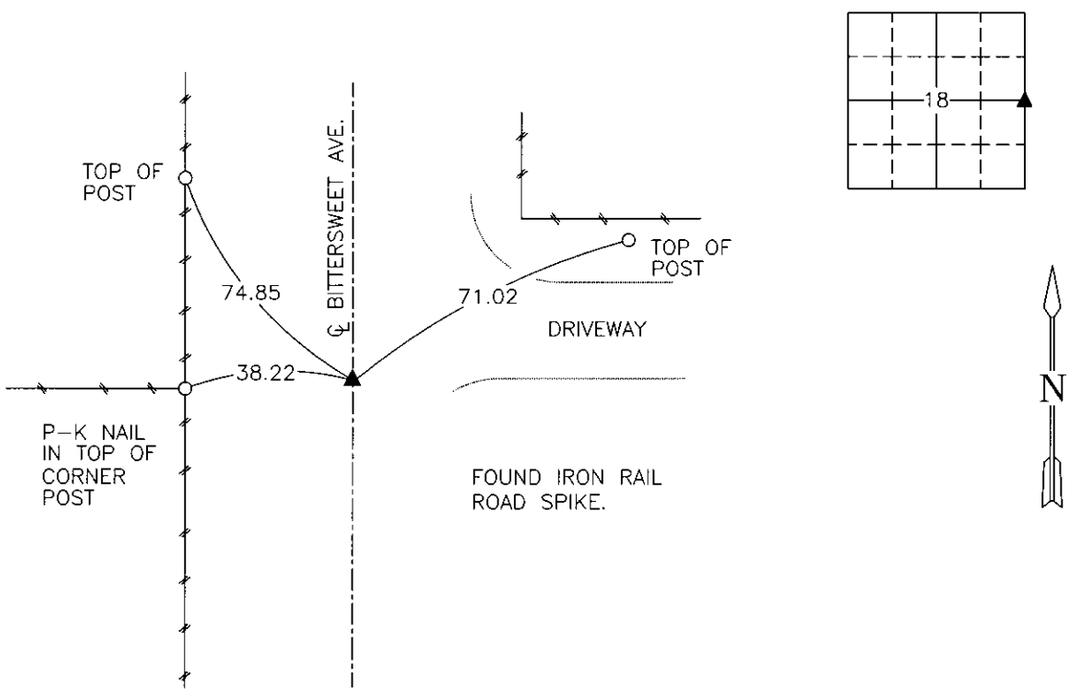

NE. COR., NE. 1/4, SE. 1/4, SEC. 18

NOTE: ALL TIES TO "X" NAILS UNLESS NOTED

LICENSED PROFESSIONAL ENGINEER & LAND SURVEYOR
MICHAEL JAMES HACKETT 14672
IOWA

I hereby certify that this land surveying document was prepared and the related survey work was performed by me or under my direct personal supervision and that I am a duly Licensed Land Surveyor under the laws of the State of Iowa.

Signed _____ Date 6-23-08
Michael James Hackett

Iowa license number 14672.
My license renewal date is 12/31/2008.
Pages covered by this seal: 1.

36-08-04