Document 2008 1997
Book 2008 Page 1997 Type 06 043 Pages 1
Date 6/23/2008 Time 2:48 PM
Rec Amt $7.00
INDX ✓
ANNO
SCAN
LISA SMITH. COUNTY RECORDER
MADISON IOWA
CHEK

HACKETT SURVEYING, Prepared By: Michael James Hackett, 712 North 9th. Ave., Winterset, Ia. 50273, Tel. (515) 462-1106

UNITED STATES PUBLIC LAND SURVEY CORNER CERTIFICATE OF


Land Survey Monuments situated in Section 18, Township 75 N, Range 29 W, of the Fifth Principal Meridian, Madison County,Iowa.
Previously recorded in _____ in County Recorder's Office.
(book, page, document number,etc.)


(Show reason for preparing this certificate, the evidence and detailed procedures used in establishing the corner positions and monumentation found or placed.)

Monument Description and Remarks: Searched and probed for corner with nothing found. Set 5/8" x 18" rebar with red plastic cap, PLS #14672. The position of the corner is based on calculating the intersection of the found northeast corner of the Northeast Quarter of the Southeast Quarter and the fence that runs east and west and north and south along the north and west of the Southeast Quarter The existing fence evidence reasonably concurs with a plat of survey dated May 10, 1876, on file in Book 2, Page 239 Madison County Engineers Office.

PLAN VIEW

(Show a minimum of three reference ties to durable physical objects, relevant monuments and physical conditions that will enable recovery of the corner.)

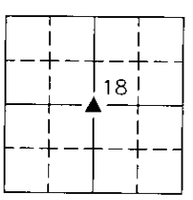

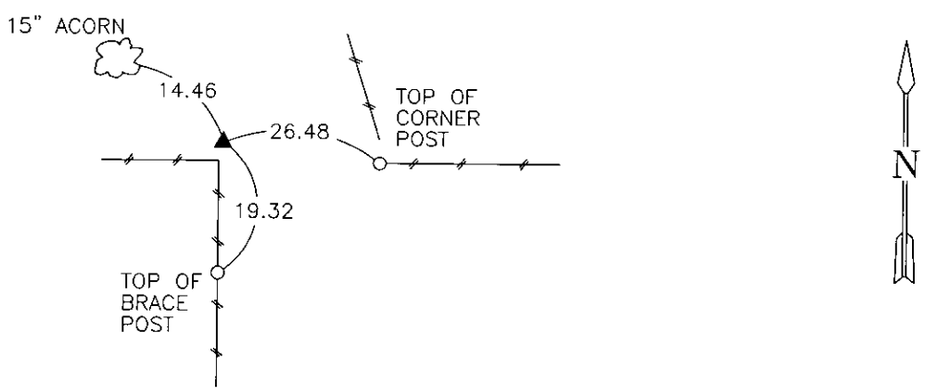

NW. COR., NW. 1/4, SE. 1/4, SEC. 18

NOTE: ALL TIES TO "X" NAILS UNLESS NOTED

LICENSED PROFESSIONAL ENGINEER & LAND SURVEYOR
MICHAEL JAMES HACKETT 14672
IOWA

I hereby certify that this land surveying document was prepared and the related survey work was performed by me or under my direct personal supervision and that I am a duly Licensed Land Surveyor under the laws of the State of Iowa.

Signed _____ Date 6-23-08
Michael James Hackett

Iowa license number 14672.
My license renewal date is 12/31/2008.
Pages covered by this seal: 1.

36-08-01