LISA SMITH. COUNTY RECORDER
MADISON IOWA

Document 2008 2193
Book 2008 Page 2193 Type 06 043 Pages 1
Date 7/11/2008 Time 12:16 PM
Rec Amt $7.00

INDX✓
ANNO
SCAN
CHEK

Prepared by: Boldman Surveying Consultants, 521 West Green St. Winterset, Ia. 50273 Ph 515-462-9242

UNITED STATES PUBLIC LAND SURVEY CORNER CERTIFICATE

OF

Land Survey Monuments situated in Section 13, Township 74, Range 28, of the Fifth Principal Meridian, Madison County, Iowa
Previously recorded in Ridge Land (book, page, document number, etc.) In County Recorder's Office.


(show reason for preparing this certificate, the evidence and detailed procedures used in establishing the corner positions and monumentation found or placed.)


Monument Description and Remarks: As shown.


All tied to pk nail and orange washer (NAW) unless noted otherwise


PLAN-VIEW OPC-orange plastic cap.

(Show a minimum of three reference ties to durable physical objects, relevant monuments and physical conditions that will enable recovery of the corner.)

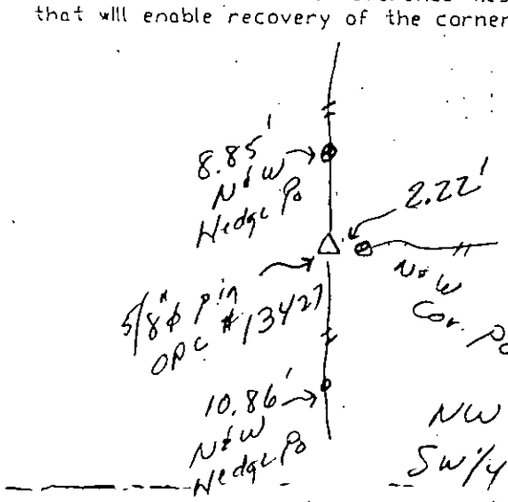

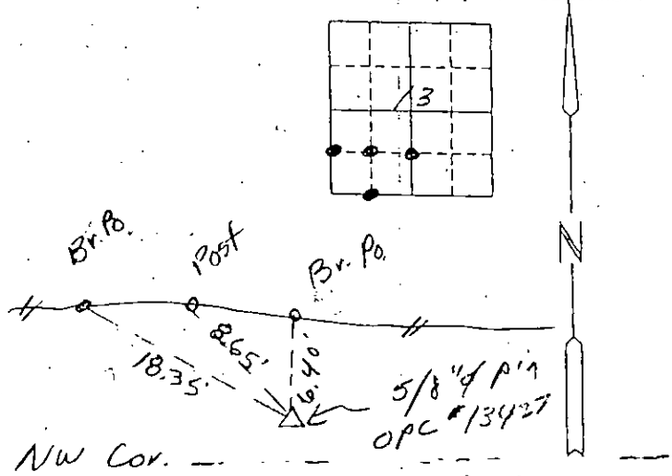

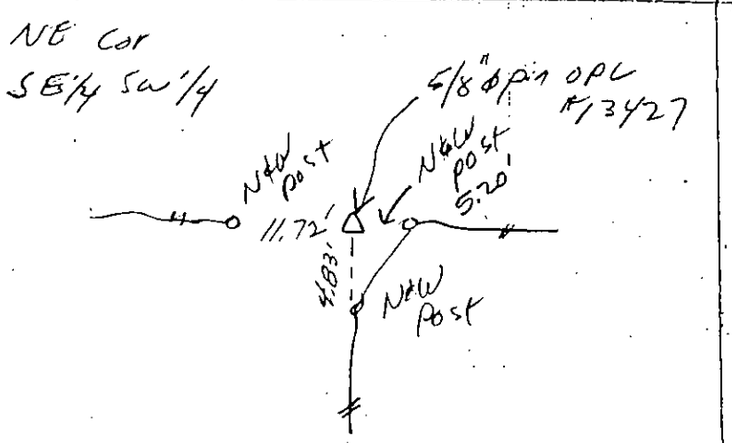

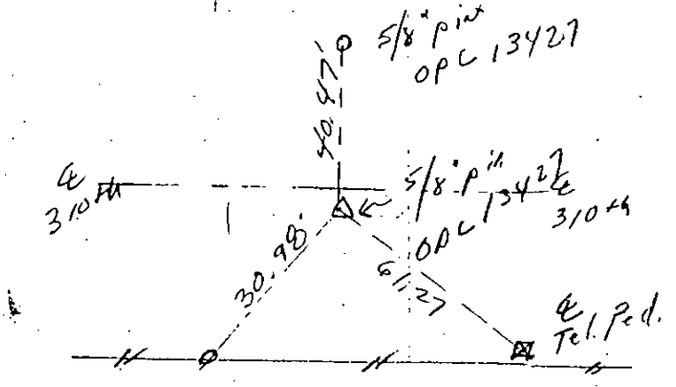

I hereby certify that the survey work was completed and this certificate was prepared by me or under my direct personal supervision and that I am a duly licensed Land Surveyor under the laws of the State of Iowa

Signature: Craig S. Boldman

Date: 7/10/08 Reg. No. 13427

SEAL

LICENSED LAND SURVEYOR
exp.
CRAIG S. BOLDMAN
13427
12/31/08
IOWA

List Corners to be Indexed

Corners	Section	Twp	Range
NW cor SW/4 SW/4	13	74	28
NE Cor SE/4 SW/4	13	74	28
NW Cor SE/4 SW/4	13	74	28
SE Cor SW/4 SW/4	13	74	28

Job # 08023