Document 2008 2301

Book 2008 Page 2301 Type 06 043 Pages 1
Date 7/23/2008 Time 2:15 PM
Rec Amt $7.00

INDX ✓
ANNO
SCAN

LISA SMITH, COUNTY RECORDER
MADISON IOWA

CHEK

VANCE & HOCHSTETLER, P.C., CONSULTING ENGINEERS, WINTERSET, IOWA (515) 462-3995
CHARLES T. VANCE, 110 West Green St., Winterset, Iowa, 50273
JAMES M HOCHSTETLER, 110 West Green St., Winterset, Iowa 50273

08-559

UNITED STATES PUBLIC LAND SURVEY CORNER CERTIFICATE

OF


Land Survey Monuments situated in Section 20, Township 76 N, Range 28 W, of the Fifth Principal Meridian, MADISON County, Iowa.
Previously recorded in _____ in County Recorder's Office.
(book, page, document number, etc.)

(Show reason for preparing this certificate, the evidence and detailed procedures used in establishing the the corner positions and monumentation found or placed.)

Monument Description and Remarks: E¼ Cor - Found CIR #12971 set for a Survey in the S½ SE¼SE¼ but not certified.
Center of Section - Set yellow CIR #6808 at old three-way fence Corner.
NW Cor. SE¼ SE¼ - Set yellow CIR #6808 on projection of line shown on Bishop Engineering Plat in S½ SE¼SE¼ at point halfway to N. Line of SE¼ of Section.
NE Cor SE¼ SE¼ - Set yellow CIR #6808 at midpoint on line between found SE. Cor. & E¼ Cor.

PLAN - VIEW

(Show a minimum of three reference tie s to durable physical objects, relevant monuments and physical conditions that will enable recovery of the corner.)

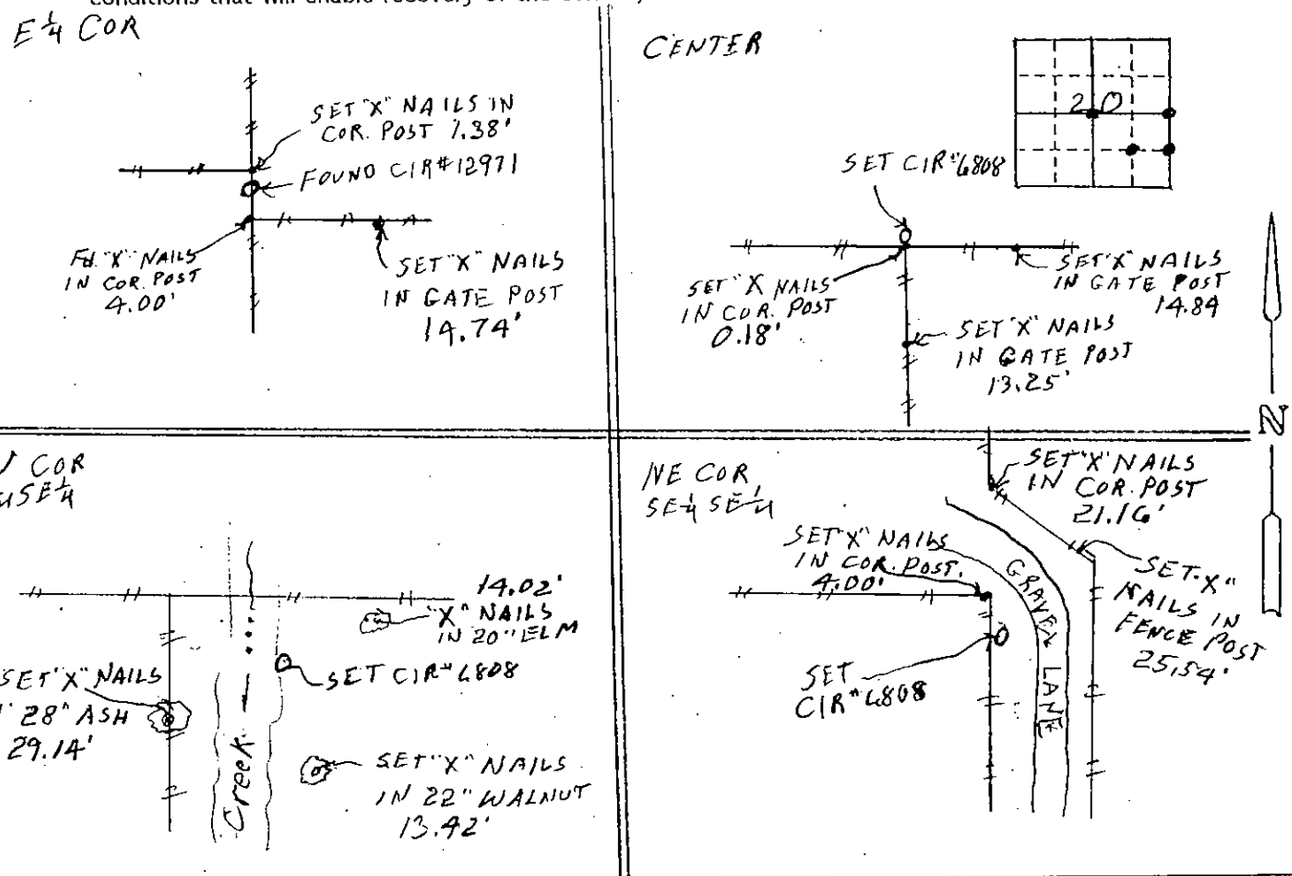

LICENSED LAND SURVEYOR
J. M. HOCHSTETLER
#6808
IOWA

I hereby certify that this land surveying document was prepared and the related survey work was performed by me or under my direct personal supervision and that I am a duly licensed Land Surveyor under the laws of the State of Iowa.

J.M. HOCHSTETLER
License number 6808 Date 7/17/08.
My license renewal date is December 31, 2009
Pages or sheets covered by this seal: 1

List Corners to be Indexed

Corners	Section	Twp	Range
E¼ COR	20	76N	28W
CENTER	20	76N	28W
NW COR SE¼ SE¼	20	76N	28W
NE COR SE¼ SE¼	20	76N	28W