Document 2008 2303
Book 2008 Page 2303 Type 06 043 Pages 1
Date 7/23/2008 Time 2:16 PM
Rec Amt $7.00

INDX ✓
ANNO
SCAN

LISA SMITH, COUNTY RECORDER
MADISON IOWA

CHEK

08935

VANCE & HOCHSTETLER, P.C., CONSULTING ENGINEERS, WINTERSET, IOWA (515) 462-3995
CHARLES T. VANCE, 110 West Green St., Winterset, Iowa, 50273
JAMES M HOCHSTETLER, 110 West Green St., Winterset, Iowa 50273

UNITED STATES PUBLIC LAND SURVEY CORNER CERTIFICATE OF

Land Survey Monuments situated in Section 13, Township 74 NORTH, Range 27 WEST, of the Fifth Principal Meridian, MADISON County, Iowa.
Previously recorded in _____ in County Recorder's Office.
(book, page, document number, etc.)

(Show reason for preparing this certificate, the evidence and detailed procedures used in establishing the the corner positions and monumentation found or placed.)

Monument Description and Remarks:


CENTER- Set Capped Iron Rod (5/8" rebar, 2" deep) #6808 at road right-of-way split in line with property line fence to South

SW corner SE.1/4 SW.1/4 - Set Capped Iron Rod (5/8" rebar, 2" deep) #6808 at road surface split in line with property line fence to South.


PLAN - VIEW


(Show a minimum of three reference ties to durable physical objects, relevant monuments and physical conditions that will enable recovery of the corner.)

CENTER
SEC. 13-74-27
Set C.I.R. #6808

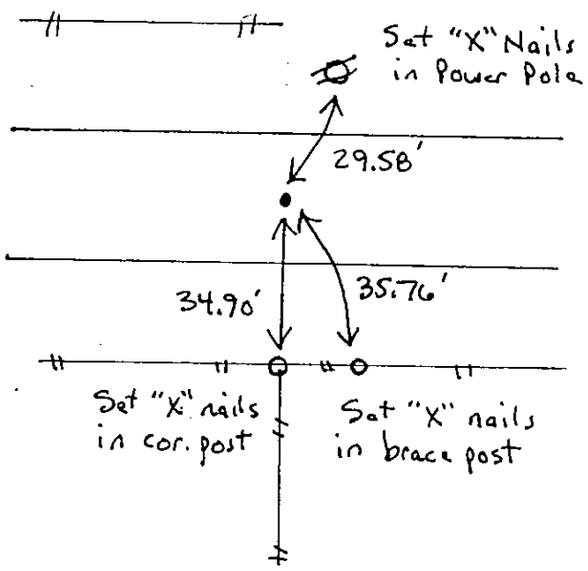

SW CORNER
SE.1/4 SW.1/4
SEC. 13-74-27
Set. C.I.R. #6808

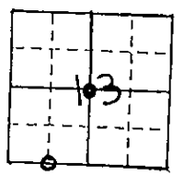

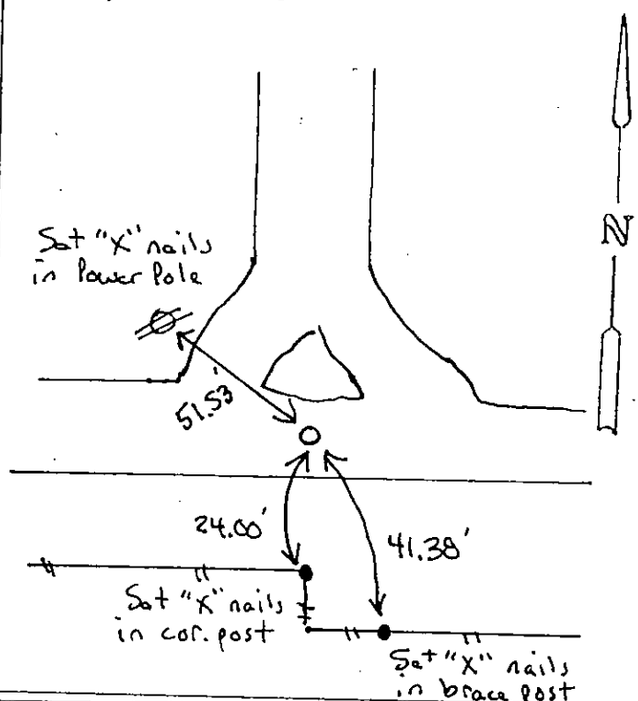

I hereby certify that this land surveying document was prepared and the related survey work was performed by me or under my direct personal supervision and that I am a duly licensed Land Surveyor under the laws of the State of Iowa.

J.M. HOCHSTETLER
License number 6808 Date 7/22/08
My license renewal date is December 31, 2009
Pages or sheets covered by this seal: 1

List Corners to be Indexed

Corners	Section	Twp	Range
• Center	13	74N	27W
○ SW cor. SE.1/4 SW.1/4	13	74N	27W