Document 2008 2956
Book 2008 Page 2956 Type 06 043 Pages 1
Date 10/03/2008 Time 11:30 AM
Rec Amt $7.00

INDX ✓
ANNO
SCAN

LISA SMITH. COUNTY RECORDER
MADISON IOWA

CHEK

VANCE & HOCHSTETLER,P.C. CONSULTING ENGINEERS, WINTERSET, IOWA (515)462-3995
CHARLES T. VANCE, 110 WEST GREEN ST.,WINTERSET, IOWA 50273
JAMES M. HOCHSTETLER, 110 WEST GREEN ST., WINTERSET, IOWA 50273

UNITED STATES PUBLIC LAND SURVEY CORNER CERTIFICATE

OF


Land Survey Monuments situated in Section 26, Township 76 North, Range 29 West, of the Fifth Principal Meridian, Madison County, Iowa.
Previously recorded in N/A (book, page, document number, etc.) in County Recorder's Office.

(Show reason for preparing this certificate, the evidence and detailed procedures used in establishing the corner positions and monumentation found or placed.)


Monument Description and Remarks: Found ½" Iron Rod at E.¼ Cor. as shown in old County Engineer Reference Book. Set C.I.R. #5041 at SW. Cor. of SE.¼ NE.¼ on Property line fence intersection.

PLAN - VIEW

(Show a minimum of three reference ties to durable physical objects, relevant monuments and physical conditions that will enable recovery of the corner.)

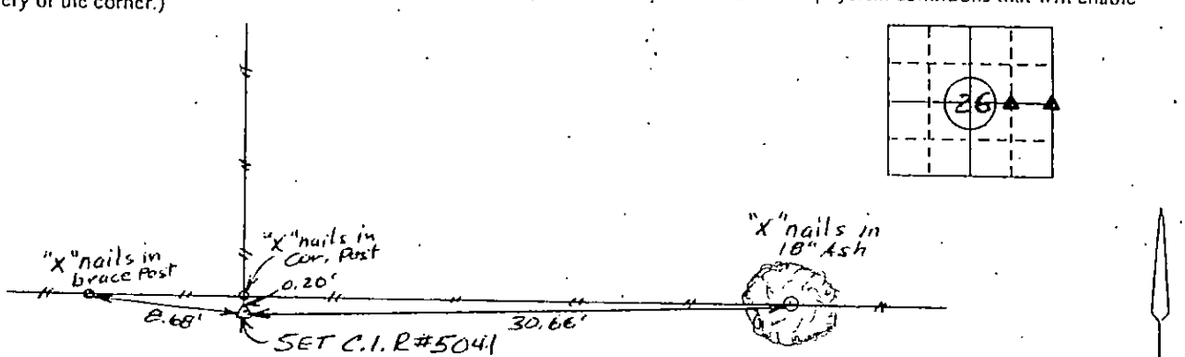

Ref. to SW. Cor. SE.¼ NE.¼ Sec. 26, T76N., R29W.

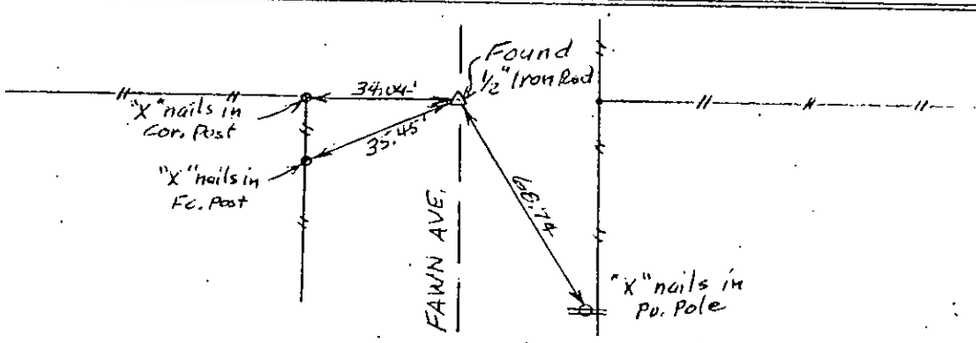

Ref. to E.¼ Cor. Section 26, T76N, R29W.

I hereby certify that this land surveying document was prepared and the related survey work was preformed by me or under my direct personal supervision and that I am a duly Licensed Land Surveyor under the laws of the State of Iowa.

Charles T. Vance 26 Sept. 2008
Charles T. Vance, PE & PLS — Date

License No. 5041

My License renewal date is 31, December 2009

List Corners to be Indexed

Corners	Section	Twp	Range
SW. Cor. SE¼ NE¼	26	T76N	R29W.
E.¼ Cor.	26	T76N	R29W.