Document 2008 3001

Book 2008 Page 3001 Type 06 043 Pages 1
Date 10/08/2008 Time 3:29 PM
Rec Amt $7.00

INDX ✓
ANNO
SCAN

LISA SMITH, COUNTY RECORDER
MADISON IOWA

CHEK

VANCE & HOCHSTETLER, P.C. CONSULTING ENGINEERS, WINTERSET, IOWA (515)462-3995
08-132s CHARLES T. VANCE, 110 WEST GREEN ST., WINTERSET, IOWA 50273
JAMES M. HOCHSTETLER, 110 WEST GREEN ST., WINTERSET, IOWA 50273

UNITED STATES PUBLIC LAND SURVEY CORNER CERTIFICATE

OF


Land Survey Monuments situated in Section 35, Township 76 North, Range 27 West, of the Fifth Principal Meridian, MADISON County, Iowa.
Previously recorded in N/A (book, page, document number, etc.) in County Recorder's Office.


(Show reason for preparing this certificate, the evidence and detailed procedures used in establishing the corner positions and monumentation found or placed.)

Monument Description and Remarks: Found C.I.R. #3169 at SE. Cor. NE¼ SW¼ Sec. 35, T 76 N, R 27 W of the 5th PM. Set C.I.R. #5041 at SW. Cor. NE¼ SE¼ Sec. 35, T 76N, R 27W on line parallel with south section line and in line with North-South property line fence.

PLAN - VIEW


(Show a minimum of three reference ties to durable physical objects, relevant monuments and physical conditions that will enable recovery of the corner.)

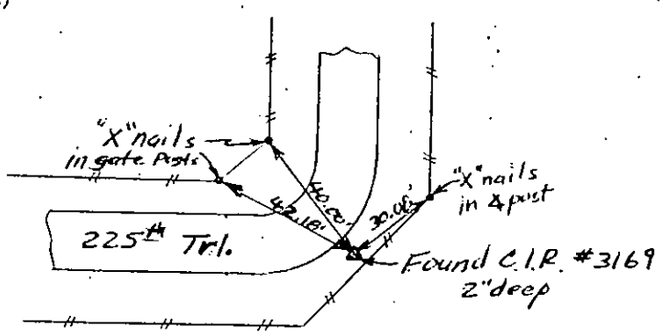

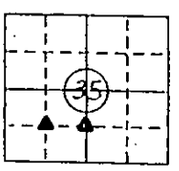

N

Ref. to SE. Cor. NE¼ SW¼ Sec. 35, T76N, R27W

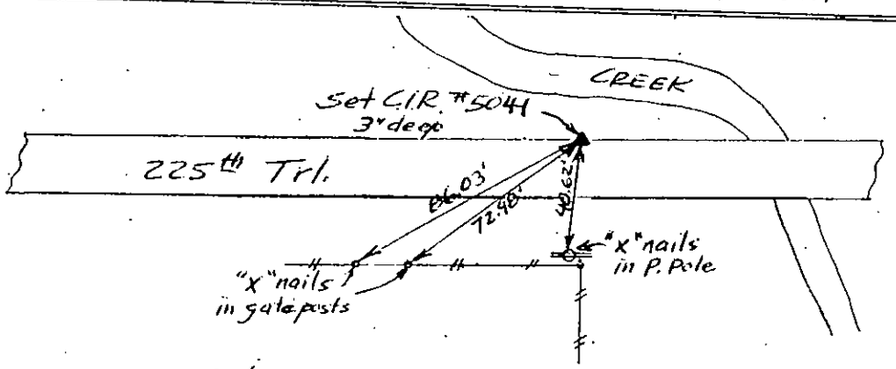

Ref. to SW. Cor. NE¼ SW¼ Sec. 35, T76N, R27W

I hereby certify that this land surveying document was prepared and the related survey work was preformed by me or under my direct personal supervision and that I am a duly Licensed Land Surveyor under the laws of the State of Iowa.

Charles T Vance 6 Oct 2008
Charles T. Vance, PE & PLS — Date

License No. 5041

My License renewal date is 31, December 2009

List Corners to be Indexed

Corners	Section	Twp	Range
SE. Cor. NE¼ SW¼	35	76	27
SW. Cor NE¼ SW¼	35	76	27