

INDX ✓
ANNO
SCAN
CHEK

LISA SMITH, COUNTY RECORDER
MADISON IOWA

VANCE & HOCHSTETLER, P.C., CONSULTING ENGINEERS, WINTERSSET, IOWA (515) 462-3995

CHARLES T. VANCE, 110 West Green St., Winterset, Iowa, 50273
JAMES M HOCHSTETLER, 110 West Green St., Winterset, Iowa 50273

08-1335

UNITED STATES PUBLIC LAND SURVEY CORNER CERTIFICATE


OF
Land Survey Monuments situated in Section 30, Township 76 N, Range
28 W, of the Fifth Principal Meridian, MADISON County, Iowa.
Previously recorded in _____ in County Recorder's Office.
(book, page, document number, etc.)

(Show reason for preparing this certificate, the evidence and detailed procedures used in establishing the the corner positions and monumentation found or placed.)


Monument Description and Remarks: Center - Set yellow CIR#6808 to replace
previously set CIR#6808 which was destroyed by new fencing. Used
distance intersect from found N 1/4 Cor, NW Cor, NE SW & SE SW Corners.
1/4 Cor - Set yellow CIR#6808 to replace R.R. spike previously set at corner
which had been destroyed. Set by distance intersect from found NE Cor, SE 1/4 SW 1/4 & SW Cor, SE 1/4 SW 1/4
NW COR SE 1/4 SW 1/4 - Set yellow CIR#6808 at midpoint on line between found
Corners at NW COR NE 1/4 SW 1/4 & SW COR SE 1/4 SW 1/4. Could not find previously set CIR#6808.

PLAN - VIEW

(Show a minimum of three reference ties to durable physical objects, relevant monuments and physical conditions that will enable recovery of the corner.)

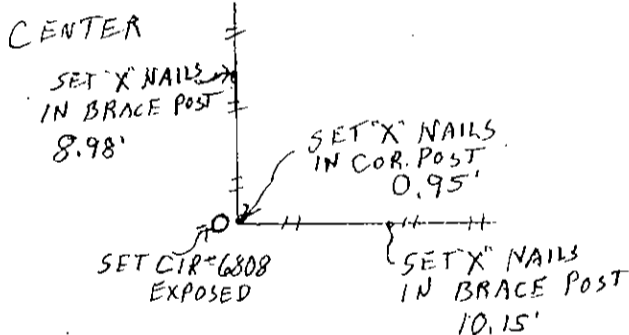

NW COR
SE 1/4 SW 1/4

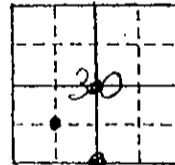


SET 'X' NAILS
IN FENCE POST
19.58'




SET CIR#6808
2.10' W. OF
FENCE.
SET 'X' NAILS
IN BRACE POST
3.93'
SET 'X' NAILS
IN BRACE POST
12.83'

1/4 COR.

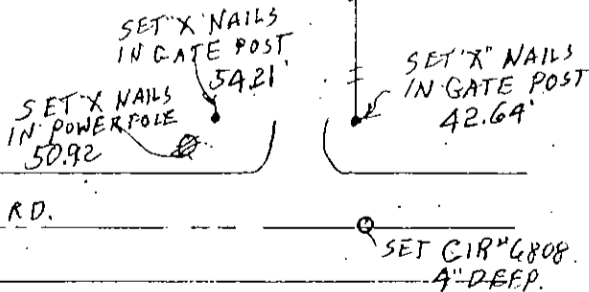

List Corners to be Indexed

Corners	Section	Twp	Range
CENTER	30	76	28
1/4 COR	30	76	28
NW COR SE 1/4 SW 1/4	30	76	28

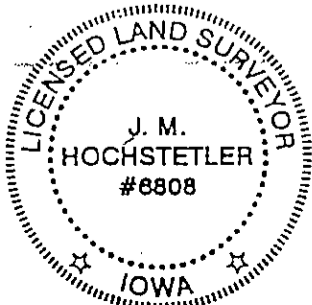

I hereby certify that this land surveying document was prepared and the related survey work was performed by me or under my direct personal supervision and that I am a duly licensed Land Surveyor under the laws of the State of Iowa.

J.M. Hochstetler
J.M. HOCHSTETLER
License number 6808 Date 10/13/08
My license renewal date is December 31, 2009
Pages or sheets covered by this seal: 1