

LISA SMITH, COUNTY RECORDER
MADISON IOWA

REAL ESTATE TRANSFER - GROUNDWATER HAZARD STATEMENT
TO BE COMPLETED BY TRANSFEROR

TRANSFEROR

Name: Randy K. Constable
Address: 7578 G 76 Hwy New Virginia, IA 50210
Number and Street or RR City, Town or P.O. State Zip

TRANSFeree

Name: Melissa S. Houseman
Address: 2084 310th St. Lorimor, IA 50149
Number and Street or RR City, Town or P.O. State Zip

Address of Property Transferred: 2084 310th St. Lorimor, IA 50149
Number and Street or RR City, Town, or P.O. State Zip

Legal Description of Property: Lot #1 Constable Acres.

1. Wells (check one)

- There are no known wells situated on this property.
- There is a well or wells situated on this property. The type(s), location(s) and legal status are stated below.

2. Solid Waste Disposal (check one)

- There is no known solid waste disposal site on this property.
- There is a solid waste disposal site on this property, but no notice has been received from the Department of Natural Resources that the site is deemed to be potentially hazardous.
- There is a solid waste disposal site on this property which has been deemed to be potentially hazardous by the Department of Natural Resources. The location(s) of the site(s) is stated below.

3. Hazardous Wastes (check one)


- There is no known hazardous waste on this property.
- There is hazardous waste on this property and it is being managed in accordance with Department of Natural Resources rules.

4. Underground Storage Tanks (check one)

- There are no known underground storage tanks on this property. (Note exclusions such as small farm and residential motor fuel tanks, most heating oil tanks, cisterns and septic tanks, in instructions.)
- There is an underground storage tank on this property. The type(s), size(s) and any known substance(s) contained are listed below.

5. Private Burial Site (check one)

- There are no known private burial sites on this property.
- There is a private burial site on this property. The location(s) of the site(s) is stated below. The known identifying information of the decedent is stated below.

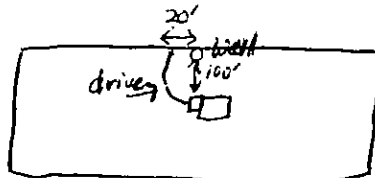

Information, if any, required by statements checked above shall be provided on a separate sheet attached hereto:

I HEREBY DECLARE THAT I HAVE REVIEWED THE INSTRUCTIONS FOR THIS FORM
AND THAT THE INFORMATION STATED ABOVE IS TRUE AND CORRECT.

Signature: *Randy K. Constable* Telephone Number: (515) 402-5150
(Transferor or Agent)