Document 2008 3361
Book 2008 Page 3361 Type 06 043 Pages 1
Date 11/14/2008 Time 10:35 AM
Rec Amt $7.00
INDX ✓
ANNO
SCAN
LISA SMITH. COUNTY RECORDER
MADISON IOWA
CHEK

Prepared By: J. Brian Morrissey, Morrissey Surveying, 1405 Hwy. G28, Otley, Ia. 50214, Tel. (641) 627-5554

UNITED STATES PUBLIC LAND SURVEY CORNER CERTIFICATE OF

Land Survey Monuments situated in Section 6, Township 77N, Range 26W, of the Fifth Principal Meridian, Madison County,Iowa.
Previously recorded in N.A. in County Recorders Office.

(book, page, document number,etc.)

(Show reason for preparing this certificate, the evidence and detailed procedures used in establishing the corner positions and monumentation found or placed.)


Monument Description and Remarks: Set orange plastic capped 5/8" x 18" rebar #7995 at mathematical intersection of Quarter corners.


Quarter corner position based on traversing all of Section 6 and using found Section corners and fence evidence.

East Quarter corner established by P.L.S. #7056, Bk. 2006, P. 971, not accepted. See Morrissey Surveying Section Corner Certificate dated 11/13/08.

PLAN VIEW

(Show a minimum of three reference ties to durable physical objects, relevant monuments and physical conditions that will enable recovery of the corner.)

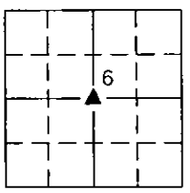

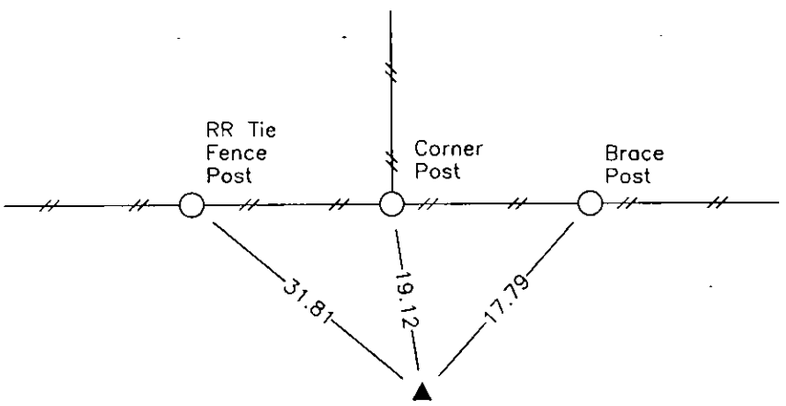




Set orange plastic capped
5/8" x 18" rebar #7995.

CENTER SEC. 6

NOTE: ALL TIES TO "X" NAILS UNLESS NOTED.

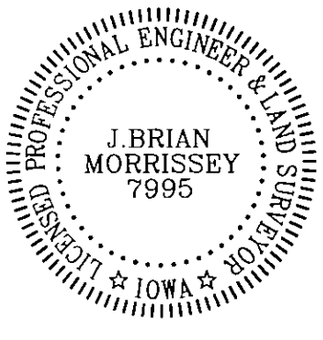

I hereby certify that this land surveying document was prepared and the related survey work was performed by me or under my direct personal supervision and that I am a duly Licensed Land Surveyor under the laws of the state of Iowa.

Signature: J. Brian Morrissey Date: 11/13/08
J. Brian Morrissey

License number 7995.
My license renewal date is December 31, 2009

528-06-2