LISA SMITH, COUNTY RECORDER
MADISON IOWA

Document 2008 3597
Book 2008 Page 3597 Type 06 043 Pages 1
Date 12/15/2008 Time 12:04 PM
Rec Amt $7.00

INDX ✓
ANNO ✓
SCAN
CHEK

Prepared by: Boldman Surveying Consultants, 521 West Green St. Winterset, Ia. 50273 Ph 515-462-9242

UNITED STATES PUBLIC LAND SURVEY CORNER CERTIFICATE

OF

Land Survey Monuments situated in Section 26, Township 77, Range 28, of the Fifth Principal Meridian, Madison County, Iowa
Previously recorded in Book 2006 Page 3232 In County Recorder's Office.
(book, page, document number, etc.)


(show reason for preparing this certificate, the evidence and detailed procedures used in establishing the corner positions and monumentation found or placed.)

Monument Description and Remarks: Some old ties missing, retied to new reference points.

All tied to pk nail and orange washer (NAW) unless noted otherwise

PLAN-VIEW

(Show a minimum of three reference ties to durable physical objects, relevant monuments and physical conditions that will enable recovery of the corner.)

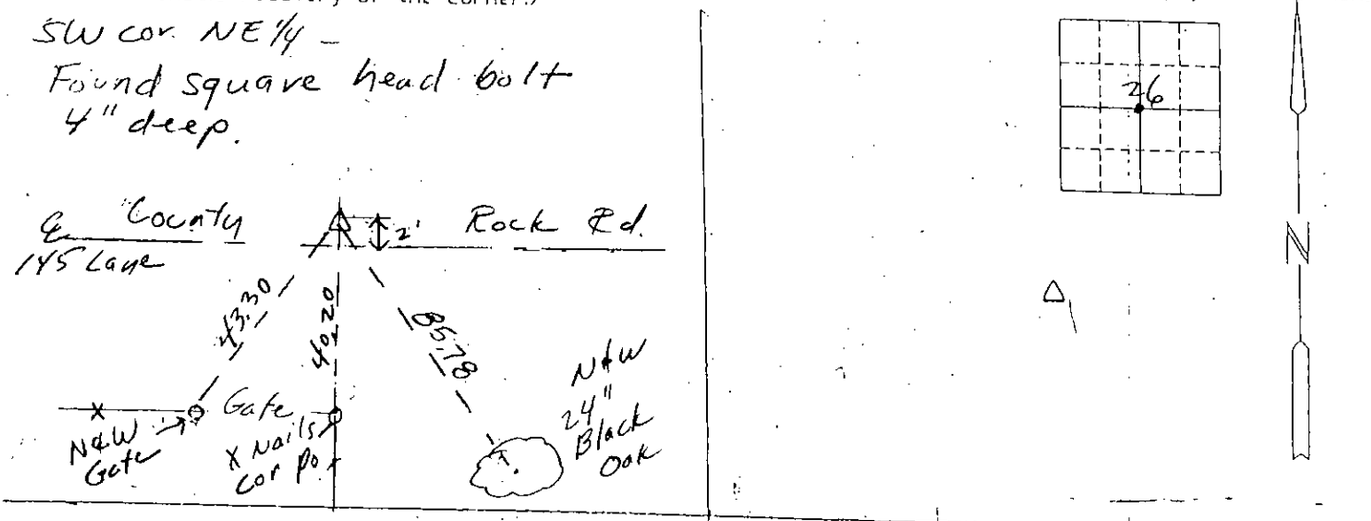


I hereby certify that the survey work was completed and this certificate was prepared by me or under my direct personal supervision and that I am a duly Licensed Land Surveyor under the laws of the State of Iowa

Signature: Craig S. Boldman

Date: 12/15/08 Reg. No. 13427

SEAL

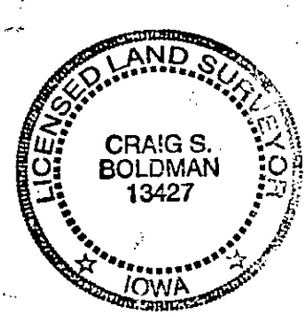

List Corners to be Indexed

Corners	Section	Twp	Range
SW cor NE¼	26	77	28

Job # 08046