

REC'D 5⁰⁰
A.M.S.
FILED 107

COMPUTER

RECORDED

COMPARED _____

MICHELLE UTSLER
RECORDER
MADISON COUNTY, IOWA

✓ RETURN TO : BOLDMAN LAND SURVEYING, P.C., BOX 66, WINTERSSET, IA 50273 515-482-9242

UNITED STATES PUBLIC LAND SURVEY CORNER CERTIFICATE


OF 17 Township 75N, Range _____
Land Survey Monuments situated in Section 26 W, of the Fifth Principal Meridian, Madison County, Iowa
Previously recorded in None In County Recorder's Office.
(book, page, document number, etc.)

(show reason for preparing this certificate, the evidence and detailed procedures used in establishing the corner positions and monumentation found or placed.)


Monument Description and Remarks: Set 5/8" rebar with yellow plastic cap # 13427. by traversing North half of Sec. 17 using found monuments

PLAN-VIEW

(Show a minimum of three reference ties to durable physical objects, relevant monuments and physical conditions that will enable recovery of the corner.)

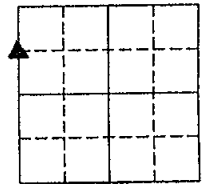

All pk nails in wood posts

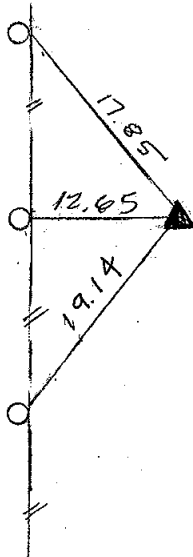

Ref. NW cor. SW 1/4 NW 1/4

I hereby certify that the survey work was completed and this certificate was prepared by me or under my direct personal supervision and that I am a duly Licensed Land Surveyor under the laws of the State of Iowa

Signature: Craig S. Boldman
Craig S. Boldman

Date: 6-14-00 Reg. No. 13427

List Corners to be Indexed

Corners	Section	Twp	Range
NW cor SW 1/4 NW 1/4	17	75	26

SEAL

