

FILED NO. **006201**

REC \$ 5.00  
AUD \$ 1.00  
R.M.F. \$ 1.00

COMPUTER   
RECORDED   
COMPARED \_\_\_\_\_

BOOK 2 PAGE 178  
2000 OCT -2 PM 3:14

MICKI UTSLER  
RECORDER  
MADISON COUNTY, IOWA

VANCE & HOCHSTETLER, P.C., CONSULTING ENGINEERS, WINTERSSET, IOWA (515) 462-3995  
CHARLES T. VANCE, 110 West Green St., Winterset, Iowa, 50273  
JAMES M HOCHSTETLER, 110 West Green St., Winterset, Iowa 50273

UNITED STATES PUBLIC LAND SURVEY CORNER CERTIFICATE

OF  
Land Survey Monuments situated in Section 30, Township 76 North, Range 26 West, of the Fifth Principal Meridian, Madison County, Iowa.  
Previously recorded in \_\_\_\_\_ in County Recorder's Office.  
(book, page, document number, etc.)

(Show reason for preparing this certificate, the evidence and detailed procedures used in establishing the the corner positions and monumentation found or placed.)


Monument Description and Remarks:

SE cor. NE. 1/4 NE. 1/4 - Set Capped Iron Rod (1/2" rebar, exposed) #6808 at existing fence corner. (3-way: North, South & West)  
SW cor. NE. 1/4 NE. 1/4 - Set Capped Iron Rod (1/2" rebar, exposed) #6808 at existing fence corner. (3-way: East, West & South)




PLAN - VIEW

(Show a minimum of three reference ties to durable physical objects, relevant monuments and physical conditions that will enable recovery of the corner.)

SE CORNER  
NE. 1/4 NE. 1/4  
SEC. 30-76-26  
Set C.I.R. #6808

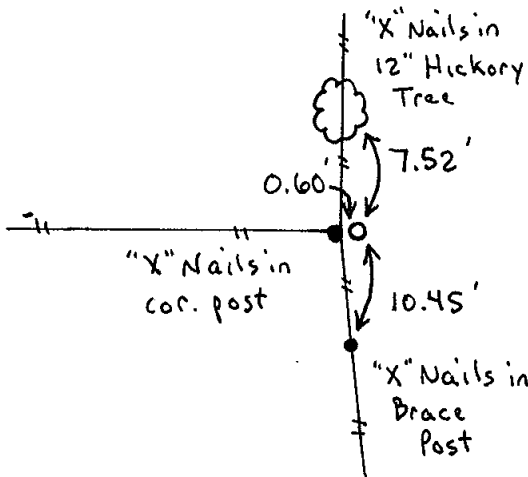

SW CORNER  
NE. 1/4 NE. 1/4  
SEC. 30-76-26  
Set C.I.R. #6808

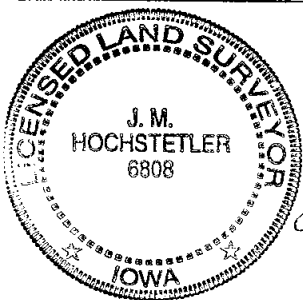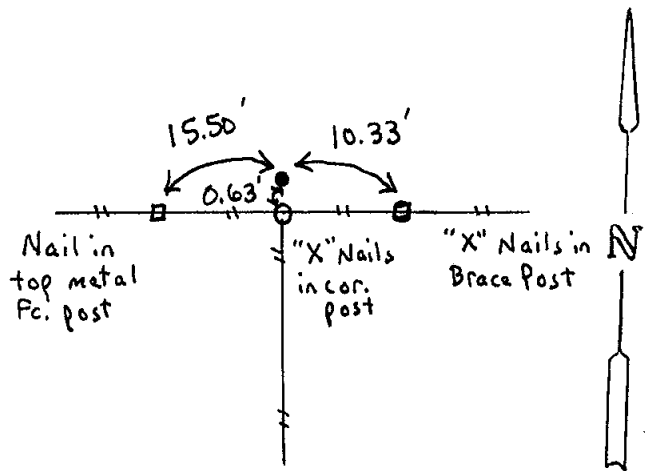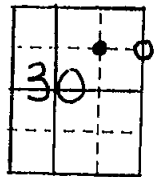

I hereby certify that this land surveying document was prepared and the related survey work was performed by me or under my direct personal supervision and that I am a duly licensed Land Surveyor under the laws of the State of Iowa.

J.M. Hochstetler  
J.M. HOCHSTETLER  
License number 6808 Date 9/27/2000  
My license renewal date is December 31, 2001  
Pages or sheets covered by this seal: 1

List Corners to be Indexed

| Corners                    | Section | Twp | Range |
|----------------------------|---------|-----|-------|
| SE cor.<br>NE. 1/4 NE. 1/4 | 30      | 76N | 26W   |
| SW cor.<br>NE. 1/4 NE. 1/4 | 30      | 76N | 26W   |