

005768
 FILED NO. _____
 BOOK 2 PAGE 172
 2000 AUG 30 PM 1:32

COMPUTER
 RECORDED
 COMPARED _____
 REC \$ 5.00
 AUD \$ _____
 R.M.F. \$ 1.00

MICKI UTSLER
 RECORDER
 MADISON COUNTY, IOWA

VANCE & HOCHSTETLER, P.C., CONSULTING ENGINEERS, WINTERSSET, IOWA (515) 462-3995
 CHARLES T. VANCE, 110 West Green St., Winterset, Iowa, 50273
 JAMES M HOCHSTETLER, 110 West Green St., Winterset, Iowa 50273





UNITED STATES PUBLIC LAND SURVEY CORNER CERTIFICATE

Land Survey Monuments situated in Section 28 OF 28 Township 75 North, Range 27 West, of the Fifth Principal Meridian, MADISON County, Iowa.
 Previously recorded in _____ in County Recorder's Office.
 (book, page, document number, etc.)

(Show reason for preparing this certificate, the evidence and detailed procedures used in establishing the the corner positions and monumentation found or placed.)

Monument Description and Remarks:
Center - Fd. Square headed bolt (6" deep) at road intersection.
Corner was previously referenced in 1983 by a crew from
the Madison County Engineer's Office. A 5/8" Iron Rod (6" deep)
previously used for a survey in 1977 was also Found 3.29' South
& 1.27' west of this bolt. We used the bolt as a corner because
of the prior County reference and because it was a better fit with
2 other corners found to PLAN - VIEW the East.
 (Show a minimum of three reference ties to durable physical objects, relevant monuments and physical conditions that will enable recovery of the corner.)

CENTER
 SEC. 28-75-27
 Fd. Square headed
 Bolt

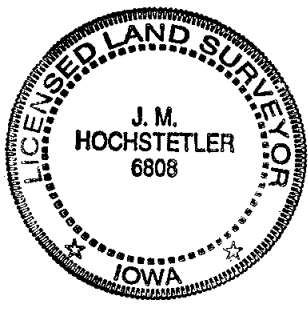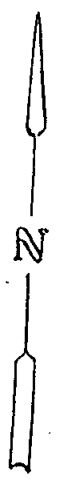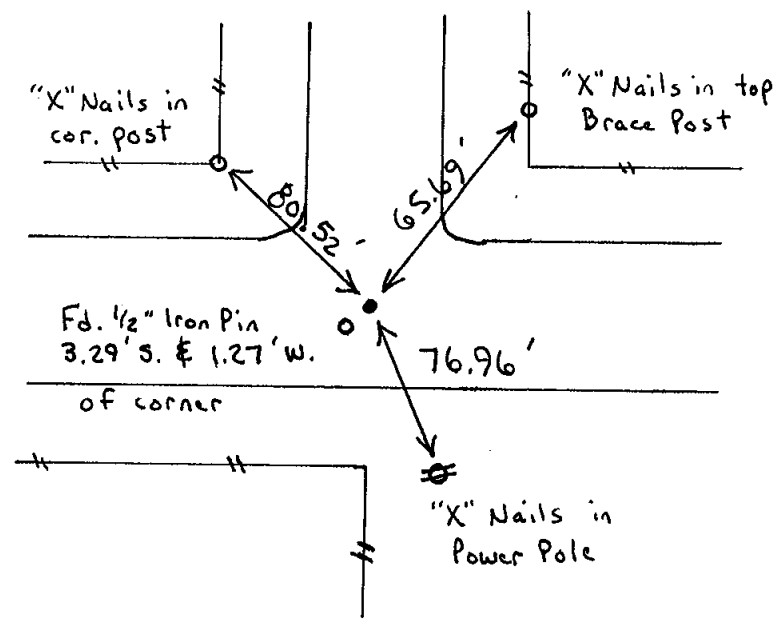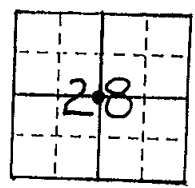

I hereby certify that this land surveying document was prepared and the related survey work was performed by me or under my direct personal supervision and that I am a duly licensed Land Surveyor under the laws of the State of Iowa.
J. M. Hochstetler
 J. M. HOCHSTETLER
 License number 6808 Date 8/21/2000
 My license renewal date is December 31 2001
 Pages or sheets covered by this seal: _____

List Corners to be Indexed

Corners	Section	Twp	Range
Center	28	75N	27W