FILED NO. 007676

BOOK 3 PAGE 664


REC \$5.00 AUD \$ R.M.F. \$1.00

COMPUTER 
RECORDED 
COMPARED

2000 DEC 28 PM 2: 19

COMPARED MICKI UTSLER
RECORDER
WANCE & HOCHSTETLER, P.C. CONSULTING ENGINEERS, WINTERSET, IOWA (515) 462-3995
CHARLES T. VANCE, 110 WEST GREEN ST., WINTERSET, IOWA 50273
JAMES M HOCHSTETLER, 110 WEST GREEN ST., WINTERSET, IOWA 50273

PLAT OF SURVEY FOR A. NEAL DAY AND MARILYN M. DAY IN THE SOUTHEAST QUARTER OF THE SOUTHWEST QUARTER OF SECTION 27 AND THE NORTHEAST QUARTER OF THE NORTHWEST QUARTER OF SECTION 34 ALL IN TOWNSHIP 77 NORTH, RANGE 28 WEST OF THE 5<sup>TH</sup> P.M.,

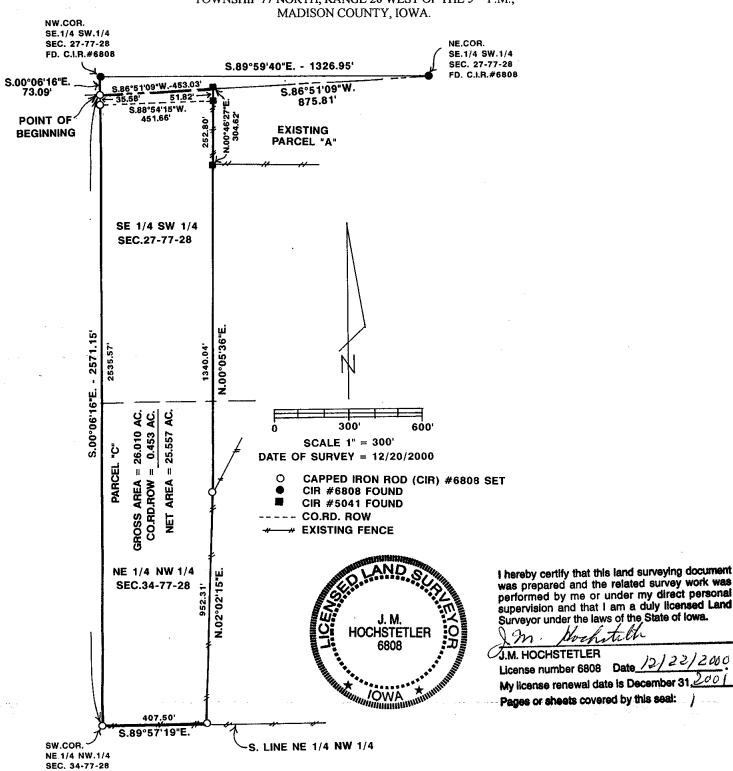

## LEGAL DESCRIPTION:

SET C.I.R.#6808

Parcel "C" in the Southeast Quarter of the Southwest Quarter of Section 27 and the Northeast Quarter of the Northwest Quarter of Section 34 all in Township 77 North, Range 28 West of the 5<sup>th</sup> P.M. Madison County, Iowa more particularly described as follows:

Commencing at the Northwest Corner of the Southeast Quarter of the Southwest Quarter of Section 27, Township 77 North, Range 28 West of the 5<sup>th</sup> P.M., Madison County, Iowa; thence South 00°06'16" East 73.09 feet along the West line of said Southeast Quarter of the Southwest Quarter to the Point of Beginning; Thence South 00°06'16" East 2571.15 feet to the Southwest Corner of the Northeast Quarter of the Northwest Quarter of Section 34, Township 77 North, Range 28 West of the 5<sup>th</sup> P.M., Madison County, Iowa; thence South 89°57'19" East 407.50 feet along the South line of said Northeast Quarter of the Northwest Quarter; thence North 02°02'15" East 952.31 feet; thence North 00°05'36" East 1340.04 feet to the Southwest Corner of existing Parcel "A"; thence North 00°46'27" East 304.62 feet to the centerline of a county road; thence South 86°51'09" West 453.03 feet to the Point of Beginning containing 26.010 acres including 0.453 acres of County Road right-of-way.