REC $ 5.00
AUD $
R.M.F. $ 1.00

COMPUTER X
RECORDED X
COMPARED

FILED NO. 000136
BOOK 2001 PAGE 136
2001 JAN 15 AM 8:45

MICKI UTSLER
RECORDER
MADISON COUNTY, IOWA

VANCE & HOCHSTETLER, P.C., CONSULTING ENGINEERS, WINTERSET, IOWA (515) 462-3995
CHARLES T. VANCE, 110 West Green St., Winterset, Iowa, 50273
JAMES M HOCHSTETLER, 110 West Green St., Winterset, Iowa 50273

UNITED STATES PUBLIC LAND SURVEY CORNER CERTIFICATE

2535

OF

Land Survey Monuments situated in Section 26, Township 77 N., Range 27 W, of the Fifth Principal Meridian, Madison County, Iowa.
Previously recorded in _____ (book, page, document number, etc.) in County Recorder's Office.

(Show reason for preparing this certificate, the evidence and detailed procedures used in establishing the the corner positions and monumentation found or placed.)


Monument Description and Remarks: NE COR - Found 1" IRON ROD NOTED AS SET ON A PLAT OF SURVEY BY BISHOP ENGINEERING BUT NOT CERTIFIED.


N¼ COR. - Found 1" Iron Rod NOTED AS SET ON A PLAT OF SURVEY BY BISHOP ENGINEERING BUT NOT CERTIFIED.

SE. COR. NE¼ NE¼ - Set C.I.R #6808 at existing property line fence Corner

PLAN - VIEW

(Show a minimum of three reference ties to durable physical objects, relevant monuments and physical conditions that will enable recovery of the corner.)

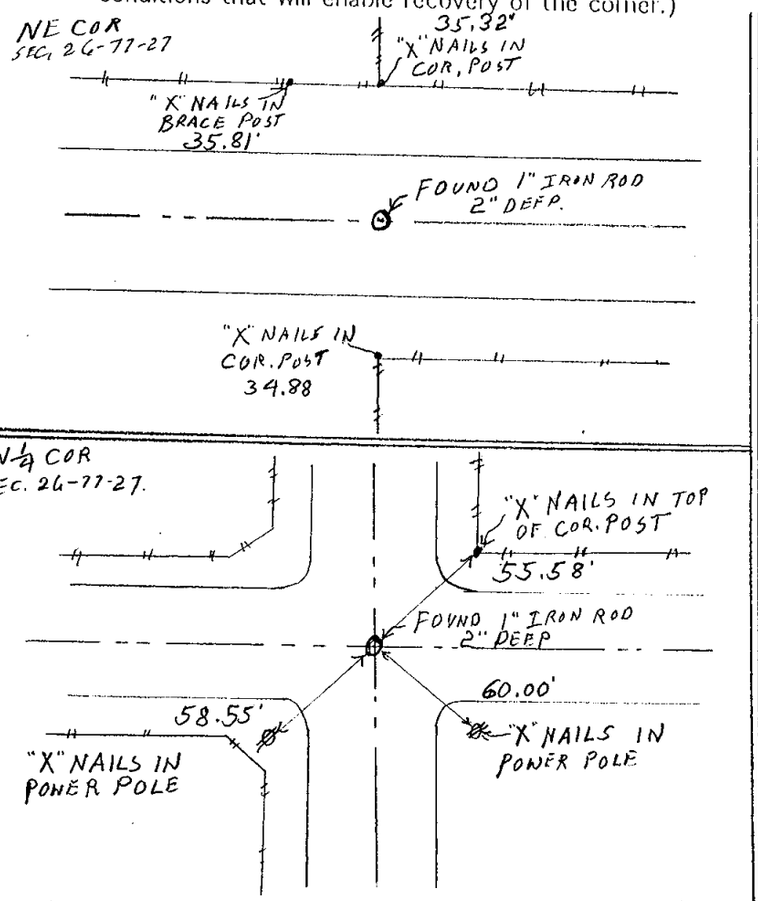

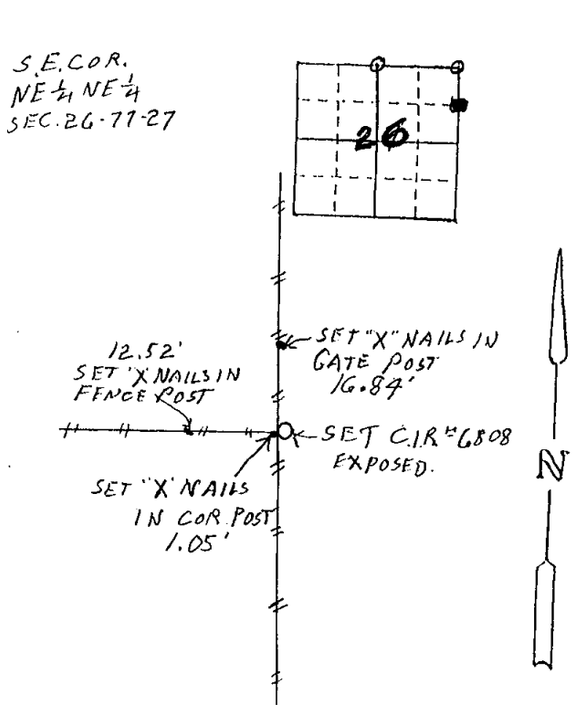

LICENSED LAND SURVEYOR
J. M. HOCHSTETLER
6808
IOWA

I hereby certify that this land surveying document was prepared and the related survey work was performed by me or under my direct personal supervision and that I am a duly licensed Land Surveyor under the laws of the State of Iowa.

J. M. Hochstetler

J. M. HOCHSTETLER

License number 6808 Date 11/5/2001

My license renewal date is December 31, 2001

Pages or sheets covered by this seal: 1

List Corners to be Indexed

Corners	Section	Twp	Range
NE. COR.	26	77N	27W
N¼ COR.	26	77N	27W
SE. COR NE¼ NE¼	26	77N	27W