FILED NO. 000701

BOOK 2001 PAGE 701

2001 FEB 27 PM 1:48

REC $ 5.00
AUD $
R.M.F. $ 1.00

COMPUTER ✓
RECORDED ✓
COMPARED ✓

MICKI UTSLER
RECORDER
MADISON COUNTY, IOWA

Prepared By: J. Brian Morrissey, Morrissey Surveying, 1405 HIGHWAY G28, OTLEY, IA 50214, Tel. (641) 627-5554

UNITED STATES PUBLIC LAND SURVEY CORNER CERTIFICATE OF

Land Survey Monuments situated in Section 7, Township 76 N, Range 27 W, of the Fifth Principal Meridian, Madison County, Iowa.
Previously recorded in N.A. in County Recorders Office.


(book, page, document number, etc.)

(Show reason for preparing this certificate, the evidence and detailed procedures used in establishing the corner positions and monumentation found or placed.)

Monument Description and Remarks: Set 5/8" x 18" rebar, with orange plastic cap, P.L.S. #7995, at intersection of line from the northwest and northeast Section corners and fence south.

PLAN VIEW

(Show a minimum of three reference ties to durable physical objects, relevant monuments and physical conditions that will enable recovery of the corner.)

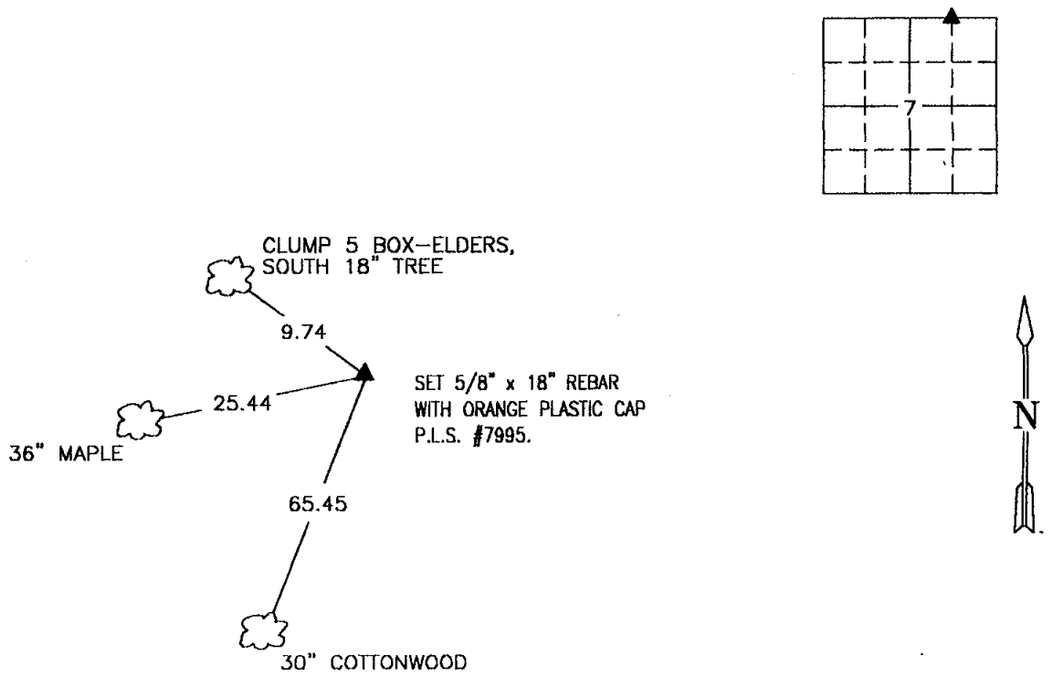

NE. COR., NW. 1/4, NE. 1/4, SEC. 7

NOTE: ALL TIES TO "X" NAILS UNLESS NOTED.

LICENSED PROFESSIONAL ENGINEER & LAND SURVEYOR
J.BRIAN MORRISSEY 7995
IOWA

I hereby certify that the survey work was completed and this certificate was prepared by me or under my direct personal supervision and that I am a duly Licensed Land Surveyor under the laws of the State of Iowa.

Signature: J. Brian Morrissey Date: 2/26/01
J. Brian Morrissey

License number 7995.
My license renewal date is December 31, 2001.

329-00-02