FILED NO. 1058

BOOK 2004 PAGE 1058

2004 MAR 10 AM 11: 18

REC $ 5.00
AUD $
R.M.F. $ 1.00
5.00

COMPUTER ✓
RECORDED ✓
COMPARED

RICKI UTSLER
RECORDER
MADISON COUNTY, IOWA

Prepared By: J. Brian Morrissey, Morrissey Surveying, 1405 Hwy G28 Otley, Iowa 50214–8518, 641–627–5554

UNITED STATES PUBLIC LAND SURVEY CORNER CERTIFICATE OF

Land Survey Monuments situated in Section 31, Township 74 N, Range 28 W, of the Fifth Principal Meridian, Madison County, Iowa.
Previously recorded in N.A. in County Recorders Office.


(book, page, document number, etc.)

(Show reason for preparing this certificate, the evidence and detailed procedures used in establishing the corner positions and monumentation found or placed.)

Monument Description and Remarks: Found 5/8" rebar set by P.L.S. 13427 for survey recorded in Farm Plat Bk. 3, P. 277. Accepted position. No certificate of record.

PLAN VIEW

(Show a minimum of three reference ties to durable physical objects, relevant monuments and physical conditions that will enable recovery of the corner.)

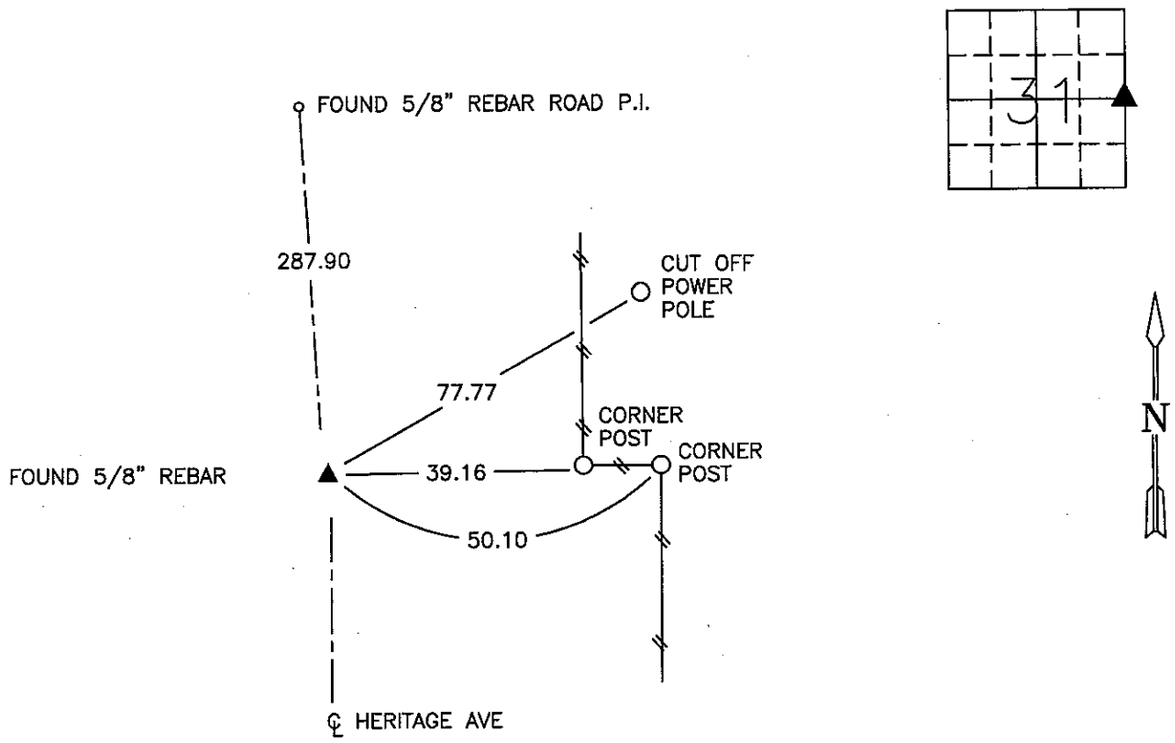

E 1/4 CORNER, SEC. 31

NOTE: ALL TIES TO "X" NAILS UNLESS NOTED.

PROFESSIONAL ENGINEER & LAND SURVEYOR
J.BRIAN MORRISSEY
7995
LICENSED
IOWA

I hereby certify that the survey work was completed and this certificate was prepared by me or under my direct personal supervision and that I am a duly Licensed Land Surveyor under the laws of the State of Iowa.

Signature: J. Brian Morrissey Date: 3/9/04
J. Brian Morrissey

License number 7995.
My license renewal date is December 31, 2005.

429–04–2