FILED NO. 1090

BOOK 2004 PAGE 1090

2004 MAR 12 PM 3:36

MICKI UTSLER
RECORDER
MADISON COUNTY, IOWA

REC $ 5.00
AUD $
R.M.F. $ 1.00
5.00

COMPUTER ✓
RECORDED ✓
COMPARED

RETURN TO: BOLDMAN LAND SURVEYING, P.C., BOX 66, WINTERSET, IA 50273 515-462-9242

UNITED STATES PUBLIC LAND SURVEY CORNER CERTIFICATE

OF


Land Survey Monuments situated in Section 20 Township 77 Range 26, of the Fifth Principal Meridian, Madison County, Iowa
Previously recorded in None found in County Recorder's Office.
(book, page, document number, etc.)


(show reason for preparing this certificate, the evidence and detailed procedures used in establishing the corner positions and monumentation found or placed.)

Monument Description and Remarks: Set 1/2 "x 24" re-rod w/ orange cap "LS 13427" Ties to pk nails w/ orange plastic washers unless noted.

PLAN-VIEW

(Show a minimum of three reference ties to durable physical objects, relevant monuments and physical conditions that will enable recovery of the corner.)

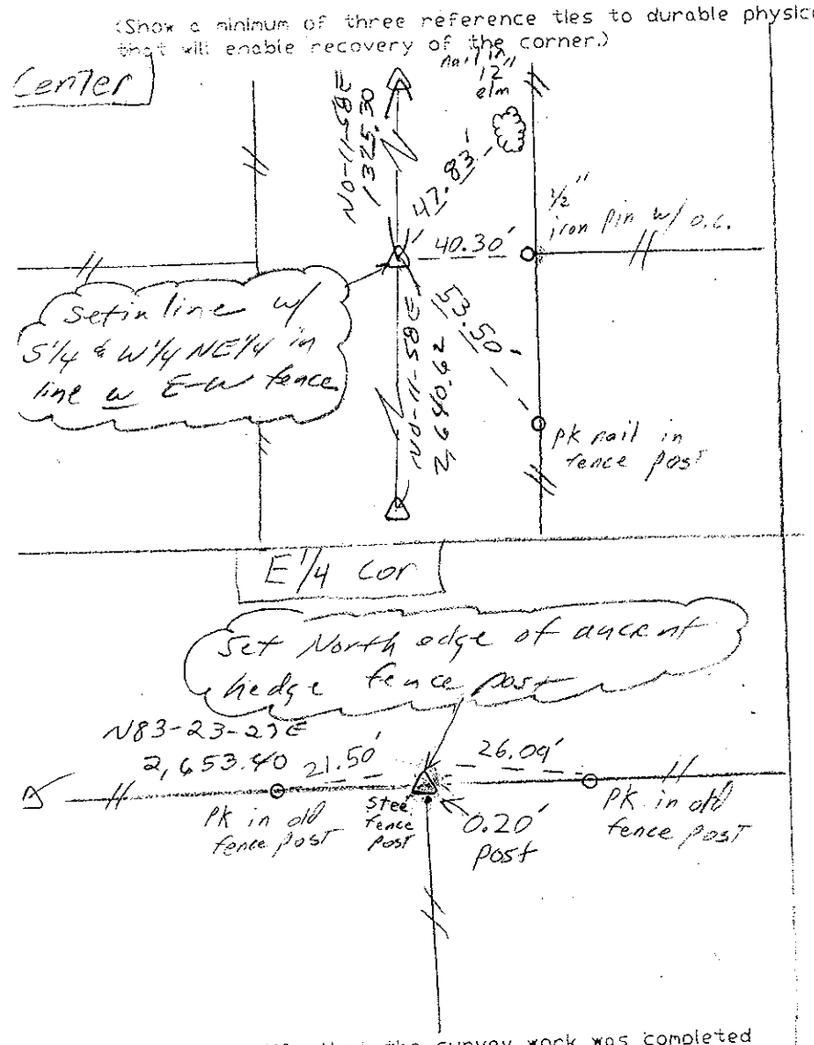

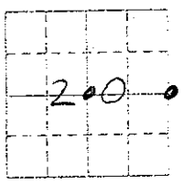


I hereby certify that the survey work was completed and this certificate was prepared by me or under my direct personal supervision and that I am a duly Licensed Land Surveyor under the laws of the State of Iowa

Signature: Craig S. Boldman

Craig S. Boldman

Date: 3/11/04 Reg. No. 13427

SEAL

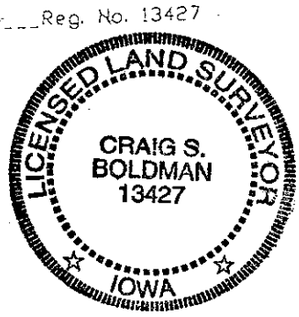

List Corners to be Indexed

Corners	Section	Twp	Range
Center	20	77	26
E1/4	20	77	26

Project 03074