FILED NO. 1092

BOOK 2004 PAGE 1092

2004 MAR 12 PM 3:38

MICKI UTSLER
RECORDER
MADISON COUNTY, IOWA

REC $ 5.00
AUD $ ____
R.M.F. $ 1.00
5.00

COMPUTER ✓
RECORDED ✓
COMPARED ____

J

RETURN TO: BOLDMAN LAND SURVEYING, P.C., BOX 66, WINTERSET, IA 50273 515-462-1692

UNITED STATES PUBLIC LAND SURVEY CORNER CERTIFICATE

OF

Land Survey Monuments situated in Section 21, Township 77, Range 26, of the Fifth Principal Meridian, Madison County, Iowa


Previously recorded in None found (book, page, document number, etc.) in County Recorder's Office.

(Show reason for preparing this certificate, the evidence and detailed procedures used in establishing the corner positions and monumentation found or placed.)

Monument Description and Remarks: Set ½" x 24" re-bar w/orange cap "LS 13427" Ties to pk nails w/orange plastic washers unless noted.

PLAN-VIEW

(Show a minimum of three reference ties to durable physical objects, relevant monuments and physical conditions that will enable recovery of the corner.)

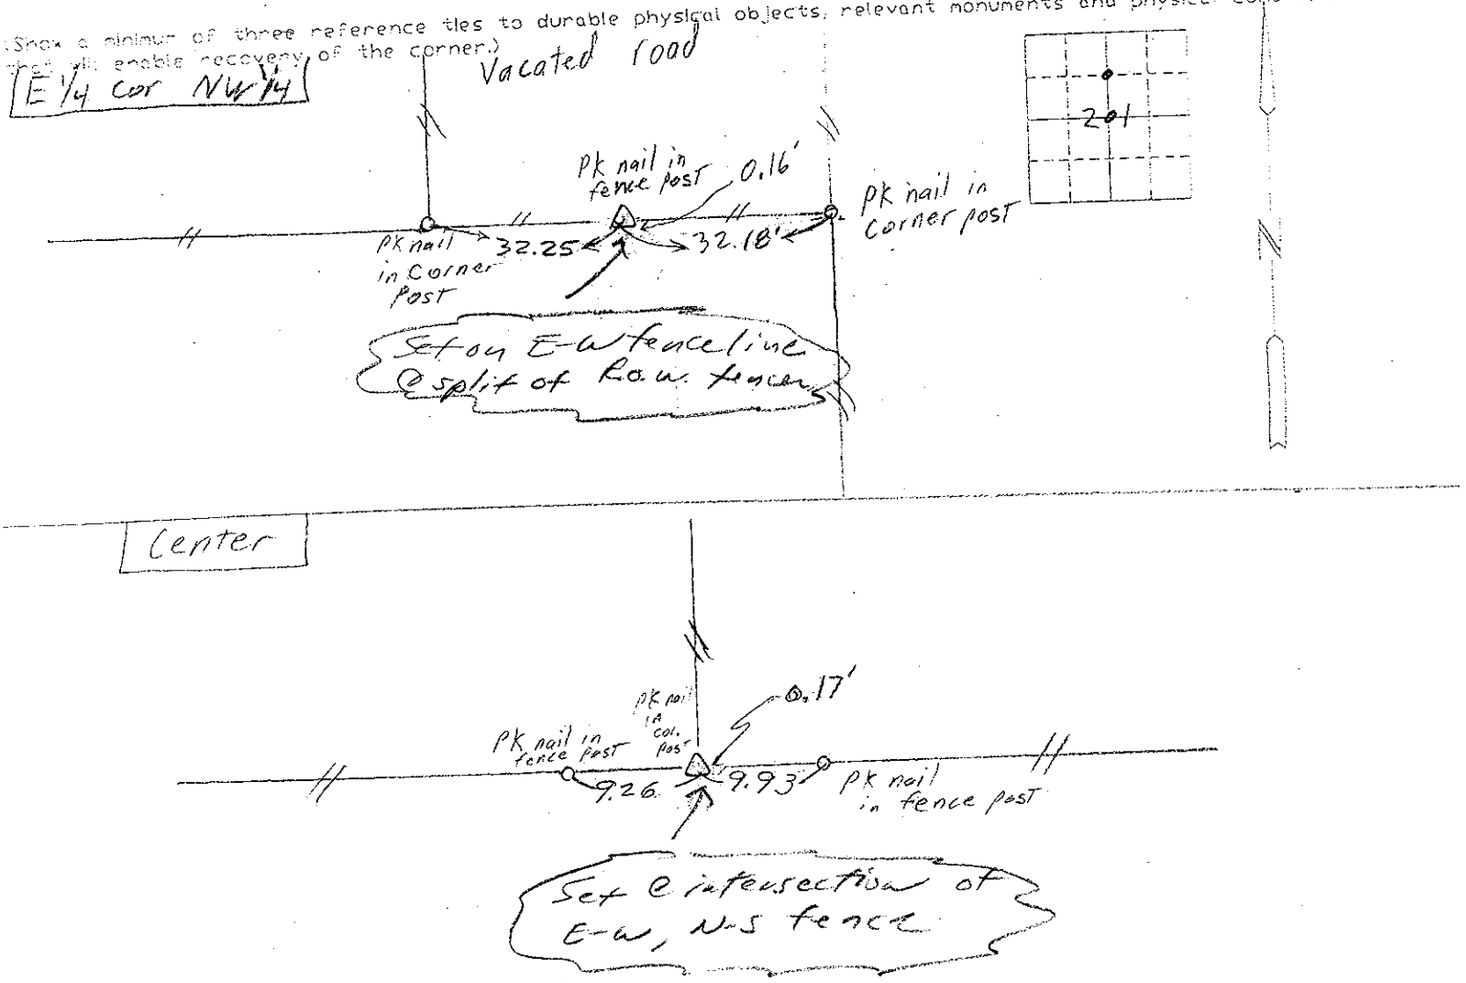

I hereby certify that the survey work was completed and this certificate was prepared by me or under my direct personal supervision and that I am a duly Licensed Land Surveyor under the laws of the State of Iowa

Signature: Craig S. Boldman

Craig S. Boldman

Date 3/11/04 Reg. No. 13427

LICENSED LAND SURVEYOR
CRAIG S. BOLDMAN
13427
IOWA

List Corners to be Indexed

Corners	Section	Twp	Range
Center	21	77	26
E¼ NW¼	21	77	26

Project 03074