FILED NO. 736

BOOK 2004 PAGE 736

2004 FEB 18 PM 3:51

MICKI UTSLER
RECORDER
MADISON COUNTY, IOWA

REC $ 5.00
AUD $
R.M.F. $ 1.00
5.00

COMPUTER ✓
RECORDED ✓
COMPARED

✓
04-12S
Wilden

VANCE & HOCHSTETLER, P.C., CONSULTING ENGINEERS, WINTERSET, IOWA (515) 462-3995
CHARLES T. VANCE, 110 West Green St., Winterset, Iowa, 50273
JAMES M HOCHSTETLER, 110 West Green St., Winterset, Iowa 50273

# UNITED STATES PUBLIC LAND SURVEY CORNER CERTIFICATE

OF


Land Survey Monuments situated in Section 14, Township 75 N, Range 27 W, of the Fifth Principal Meridian, MADISON County, Iowa.
Previously recorded in _____ (book, page, document number, etc.) in County Recorder's Office.


(Show reason for preparing this certificate, the evidence and detailed procedures used in establishing the corner positions and monumentation found or placed.)

Monument Description and Remarks: N.E. COR SE¼ NE¼ - Set yellow CIR #6808 on line between found NE Cor and SE Cor of Section and Projection of Survey Corners in the NW¼ NW¼ of Section 13.
NW COR SE¼ NE¼ - Set yellow CIR #6808 at midpoint on line between found NW Cor NE¼ NE¼ & SW COR SE¼ NE¼.

## PLAN - VIEW

(Show a minimum of three reference ties to durable physical objects, relevant monuments and physical conditions that will enable recovery of the corner.)

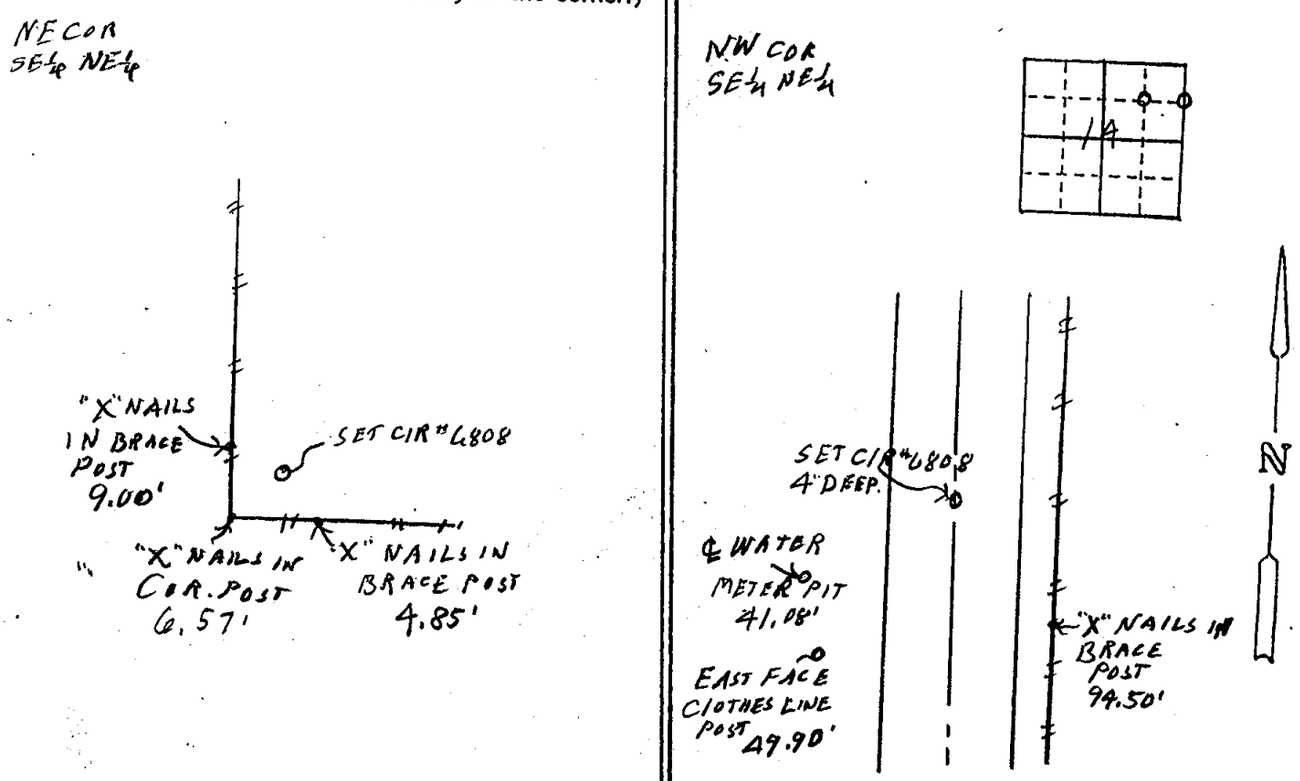

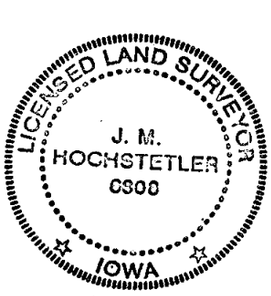
I hereby certify that this land surveying document was prepared and the related survey work was performed by me or under my direct personal supervision and that I am a duly licensed Land Surveyor under the laws of the State of Iowa.

Jim Hochstetler

J.M. HOCHSTETLER
License number 6808 Date 2/12/04
My license renewal date is December 31 2005
Pages or sheets covered by this seal: 1

List Corners to be Indexed

| Corners | Section | Twp | Range |
|---|---|---|---|
| NE COR SE¼ NE¼ | 14 | 75N | 27W |
| NW COR SE¼ NE¼ | 14 | 75N | 27W |