REC $ 5 00
AUD $ 1 00
R.M.F. $ 5 00

FILED NO. 1196
BOOK 2004 PAGE 1196
2004 MAR 19 PM 3:38

COMPUTER ✓
RECORDED ✓
COMPARED

MICKI UTSLER
RECORDER
MADISON COUNTY, IOWA

Prepared By: J. Brian Morrissey, Morrissey Surveying, 1405 Hwy. G28, Otley, Ia. 50214, Tel. (641) 627-5554

UNITED STATES PUBLIC LAND SURVEY CORNER CERTIFICATE OF

Land Survey Monuments situated in Section 23, Township 76N, Range 28W, of the Fifth Principal Meridian, MADISON County, Iowa.
Previously recorded in N.A. in County Recorders Office.


(book, page, document number, etc.)


(Show reason for preparing this certificate, the evidence and detailed procedures used in establishing the corner positions and monumentation found or placed.)

Monument Description and Remarks: Found 8" x 8" x 6" stone previously logged in old section corner tie field book in Madison County Engineer's Office, accepted position, set 5/8" x 18" orange plastic capped rebar, #7995 on S. side.

PLAN VIEW

(Show a minimum of three reference ties to durable physical objects, relevant monuments and physical conditions that will enable recovery of the corner.)

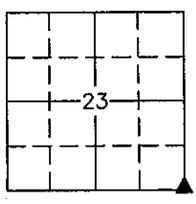

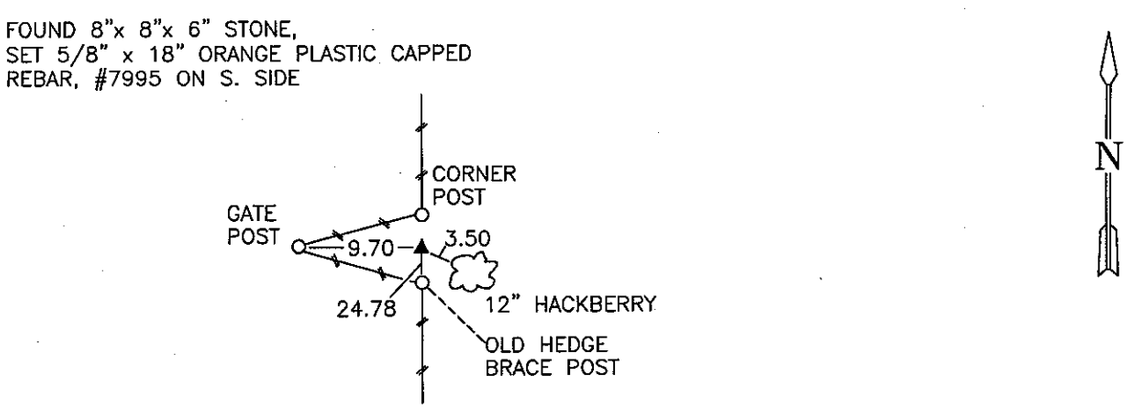

SE. COR., SEC. 23

NOTE: ALL TIES TO "X" NAILS UNLESS NOTED.

PROFESSIONAL ENGINEER & LAND SURVEYOR
J.BRIAN MORRISSEY 7995
LICENSED ☆ IOWA ☆

I hereby certify that the survey work was completed and this certificate was prepared by me or under my direct personal supervision and that I am a duly Licensed Land Surveyor under the laws of the State of Iowa.

Signature: J. Brian Morrissey Date: 3/18/04
J. Brian Morrissey
License number 7995.
My license renewal date is December 31, 2003

423-03-3