REC $ 5.00
AUD $
R.M.F. $ 1.00 5.00

FILED NO. 1304
BOOK 2004 PAGE 1304
2004 MAR 26 PM 2:37

COMPUTER ✓
RECORDED ✓
COMPARED

NICKI UTSLER
RECORDER
MADISON COUNTY, IOWA

VANCE & HOCHSTETLER, P.C., CONSULTING ENGINEERS, WINTERSET, IOWA (515) 462-3995
04-105 CHARLES T. VANCE, 110 West Green St., Winterset, Iowa, 50273
JAMES M HOCHSTETLER, 110 West Green St., Winterset, Iowa 50273

UNITED STATES PUBLIC LAND SURVEY CORNER CERTIFICATE

OF


Land Survey Monuments situated in Section 36, Township 76 N, Range 26 W, of the Fifth Principal Meridian, MADISON County, Iowa.
Previously recorded in _____ in County Recorder's Office.
(book, page, document number, etc.)

(Show reason for preparing this certificate, the evidence and detailed procedures used in establishing the the corner positions and monumentation found or placed.)

Monument Description and Remarks: NE COR SW¼ NE¼ - Found CIR #5041 at intersection of line from Calculated NE Cor. NW¼ NE¼ to Found CIR #5041 at SE Cor SW¼ NE¼ and line from Found NE Cor SE¼ NE¼ to Set NW Cor SE¼ NE¼.
NW Cor SW¼ NE¼ - Set CIR #6808 on line at midpoint between Found ½" Pipe at N¼ Cor and Found CIR #3754 at center of Section

PLAN - VIEW

(Show a minimum of three reference ties to durable physical objects, relevant monuments and physical conditions that will enable recovery of the corner.)

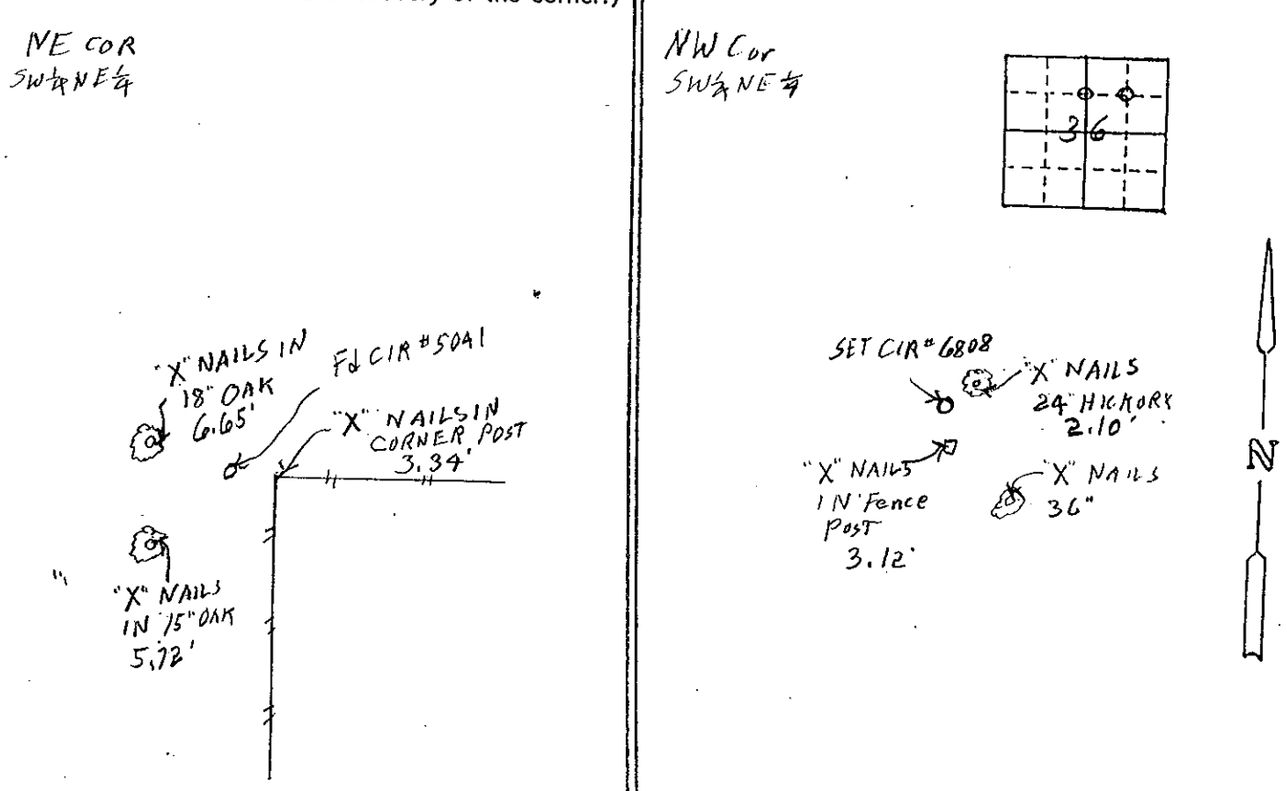

LICENSED LAND SURVEYOR
J. M. HOCHSTETLER
6808
IOWA

I hereby certify that this land surveying document was prepared and the related survey work was performed by me or under my direct personal supervision and that I am a duly licensed Land Surveyor under the laws of the State of Iowa.

J.M. Hochstetler

J.M. HOCHSTETLER
License number 6808 Date 3/24/04
My license renewal date is December 31, 2005
Pages or sheets covered by this seal: 1

List Corners to be Indexed

Corners	Section	Twp	Range
NE COR SW¼ NE¼	36	76N	26W
NW COR SW¼ NE¼	36	76N	26W