Document 2004 1666

Book 2004 Page 1666 Type 06 43 Pages 1
Date 4/16/2004 Time 11:34 AM
Rec Amt $11.00

COMPUTER ✓
RECORDED ✓
COMPARED

MICHELLE "MICKI" UTSLER, COUNTY RECORDER
MADISON IOWA

VANCE & HOCHSTETLER, P.C., CONSULTING ENGINEERS, WINTERSET, IOWA (515) 462-3995
2004-265 CHARLES T. VANCE, 110 West Green St., Winterset, Iowa, 50273
JAMES M HOCHSTETLER, 110 West Green St., Winterset, Iowa 50273

UNITED STATES PUBLIC LAND SURVEY CORNER CERTIFICATE OF


Land Survey Monuments situated in Section 1, Township 75N, Range 29W, of the Fifth Principal Meridian, MADISON County, Iowa.
Previously recorded in _____ in County Recorder's Office.
(book, page, document number, etc.)

(Show reason for preparing this certificate, the evidence and detailed procedures used in establishing the the corner positions and monumentation found or placed.)

Monument Description and Remarks: NW COR SW¼ SW¼ - Set yellow CIR #6808 on line at mid point between found SW Corner & fence corner at W¼ Cor. NE COR SW¼ SW¼ - Set yellow CIR #6808 on line at mid point between found NE COR SE¼ SW¼ and set NW Cor SW¼ SW¼. SE COR SW¼ SW¼ - Set yellow CIR #6808 4" Deep on line at mid point between found SW Cor. and S¼ Cor.

PLAN - VIEW

(Show a minimum of three reference ties to durable physical objects, relevant monuments and physical conditions that will enable recovery of the corner.)

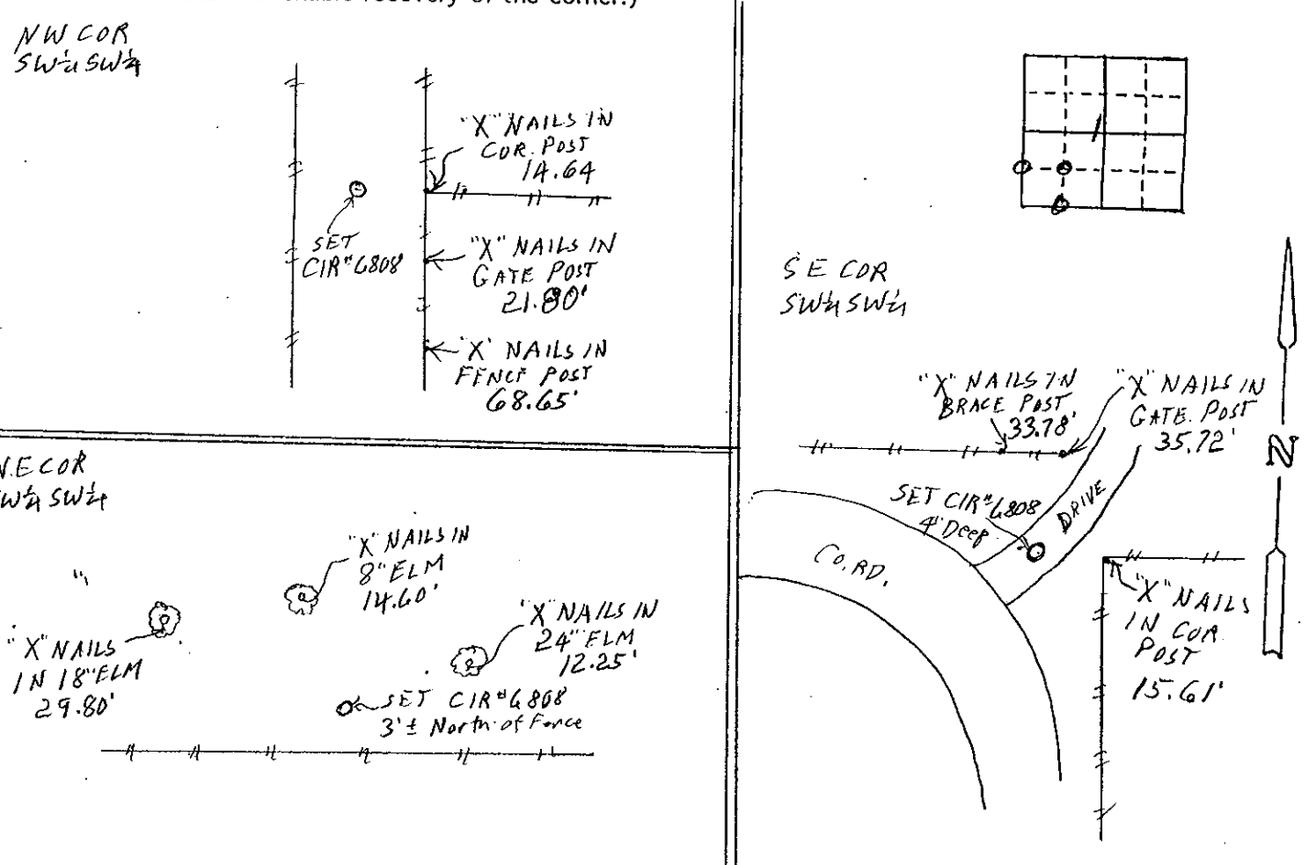

LICENSED LAND SURVEYOR
J. M. HOCHSTETLER
6808
IOWA

I hereby certify that this land surveying document was prepared and the related survey work was performed by me or under my direct personal supervision and that I am a duly licensed Land Surveyor under the laws of the State of Iowa.

J.M. HOCHSTETLER
License number 6808 Date 3/31/04.
My license renewal date is December 31 2005
Pages or sheets covered by this seal: 1

List Corners to be Indexed

Corners	Section	Twp	Range
NW COR SW¼ SW¼	1	75	29
NE COR SW¼ SW¼	1	75	29
SE COR SW¼ SW¼	1	75	29