

COMPUTER   
RECORDED   
COMPARED


MICHELLE "MICKI" UTSLER, COUNTY RECORDER  
MADISON IOWA

VANCE & HOCHSTETLER, P.C. CONSULTING ENGINEERS, WINTERSSET, IOWA (515) 462-3995

04-37s CHARLES T. VANCE, 110 WEST GREEN ST., WINTERSSET, IOWA 50273


JAMES M HOCHSTETLER, 110 WEST GREEN ST., WINTERSSET, IOWA 50273

PLAT OF SURVEY FOR BILL GARRETT OF OUTLOTS 1 AND 2 OF W.O. LEE'S  
ADDITION TO THE TOWN OF MACKSBURG, MADISON COUNTY, IOWA  
OWNED BY DONALD GARRETT.

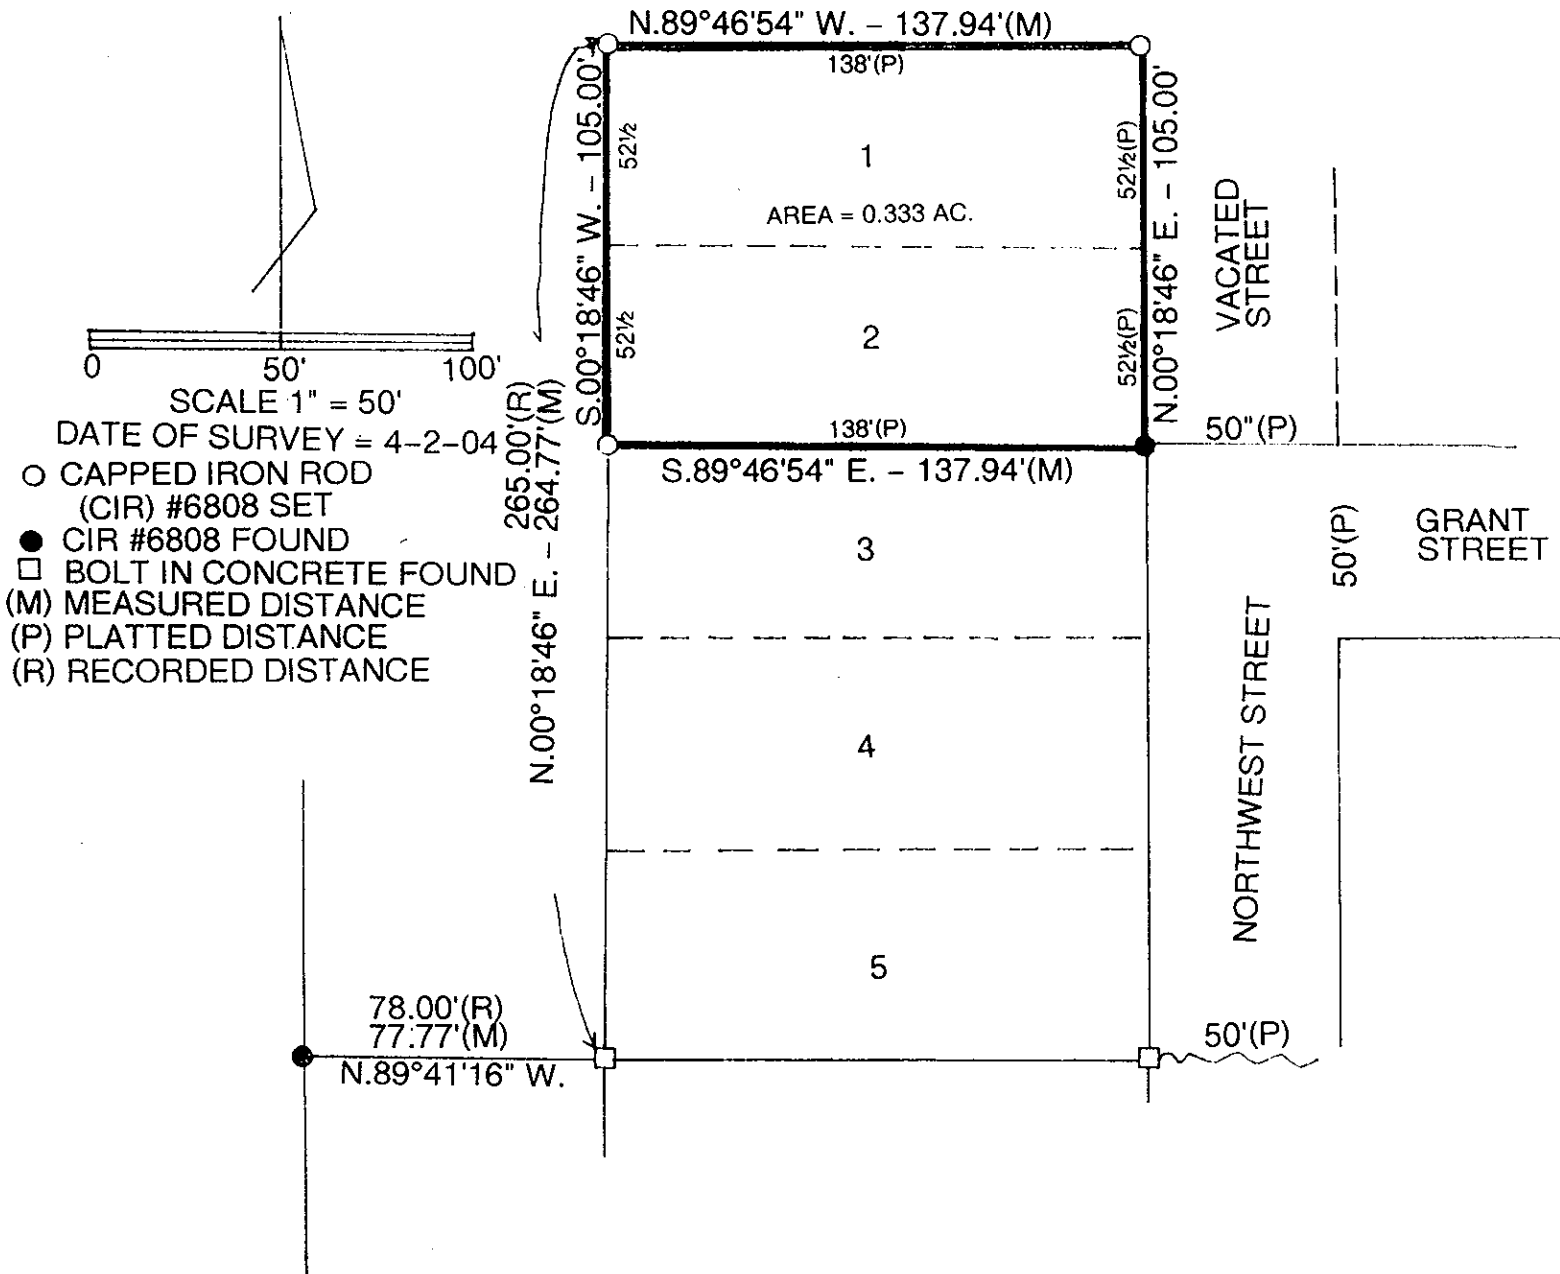

LEGAL DESCRIPTION:

Outlots 1 and 2 of W.O. Lee's Addition to the Town of Macksburg, Iowa.

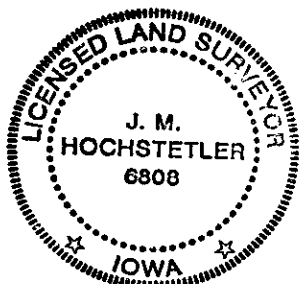

I hereby certify that this land surveying document was prepared and the related survey work was performed by me or under my direct personal supervision and that I am a duly licensed Land Surveyor under the laws of the State of Iowa.

*J.M. Hochstetler*  
J.M. HOCHSTETLER  
License number 6808 Date 4/29/04  
My license renewal date is December 31, 2005  
Pages or sheets covered by this seal: 1