
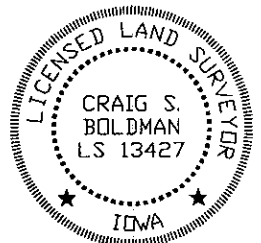


MICHELLE "MICKI" UTSLER, COUNTY RECORDER  
 MADISON IOWA

COMPUTER   
 RECORDED   
 COMPARED

Prepared by: Boldman Land Surveying, L.L.C., P.O. Box 66, Winterset, Ia. 50273. (515)462-9242

RETRACEMENT SURVEY OF THE EAST 550' OF NW 1/4 OF THE SW 1/4 OF SECTION 35, TOWNSHIP 74 NORTH, RANGE 28 WEST OF THE 5TH P.M., MADISON COUNTY, IOWA, EXCEPT FOR THAT PART THEREOF PREVIOUSLY CONVEYED FOR ROAD RIGHT-OF-WAY.

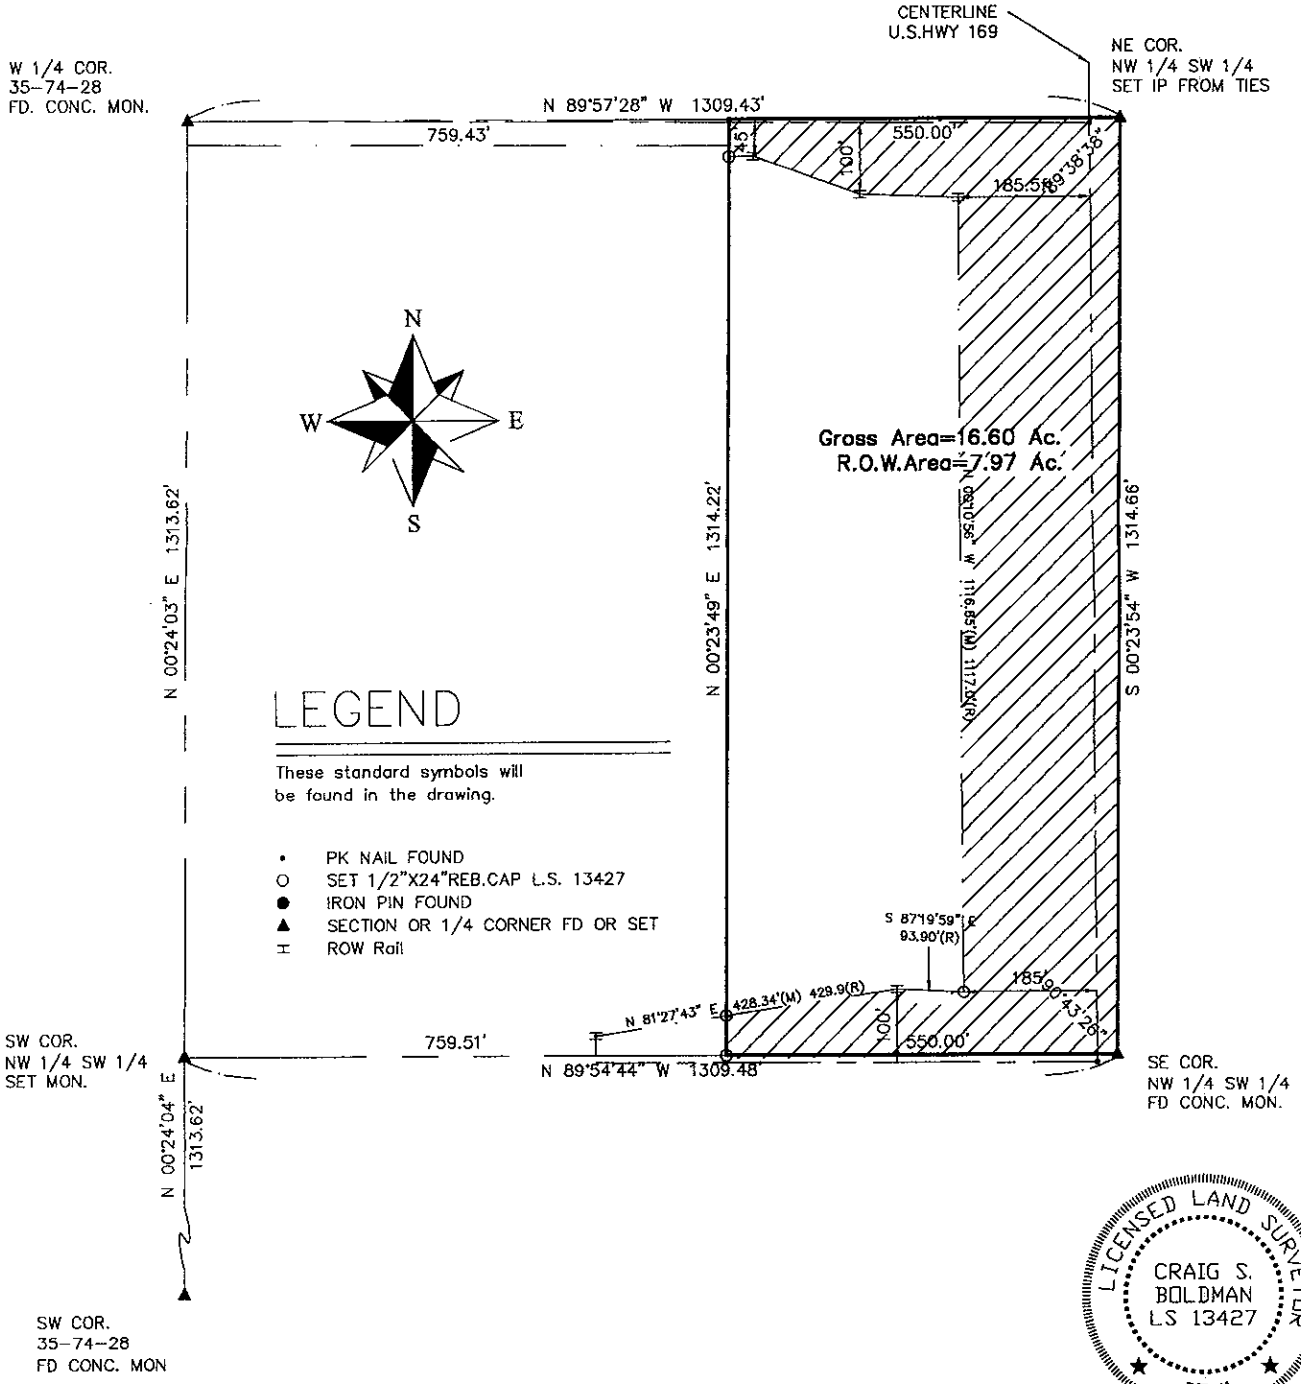

I HEREBY CERTIFY THAT THIS LAND SURVEYING DOCUMENT WAS PREPARED AND THE RELATED SURVEY WORK WAS PERFORMED BY ME OR UNDER MY DIRECT PERSONAL SUPERVISION AND THAT I AM A DULY LICENSED LAND SURVEYOR UNDER THE LAWS OF THE STATE OF IOWA.

SIGNATURE: *Craig S. Boldman*

NAME: CRAIG S. BOLDMAN

DATE: 6/15/04

MY LICENSE RENEWAL DATE IS: DECEMBER 31, 2004

REQUESTED BY: Karen Decker		BOLDMAN LAND SURVEYING, L.L.C. P.O. BOX 66 WINTERSSET, IA. 50273 (515)462-9242	
SURVEYED 5/7/04	SCALE 1"=200'	PROJECT NO. 04032	OWNER Jesse Decker