


COMPUTER
RECORDED
COMPARED

MICHELLE "MICKI" UTSLER, COUNTY RECORDER
MADISON IOWA


VANCE & HOCHSTETLER, P.C. CONSULTING ENGINEERS, WINTERSET, IOWA (515) 462-3995
CHARLES T. VANCE, 110 WEST GREEN ST., WINTERSET, IOWA 50273
JAMES M HOCHSTETLER, 110 WEST GREEN ST., WINTERSET, IOWA 50273

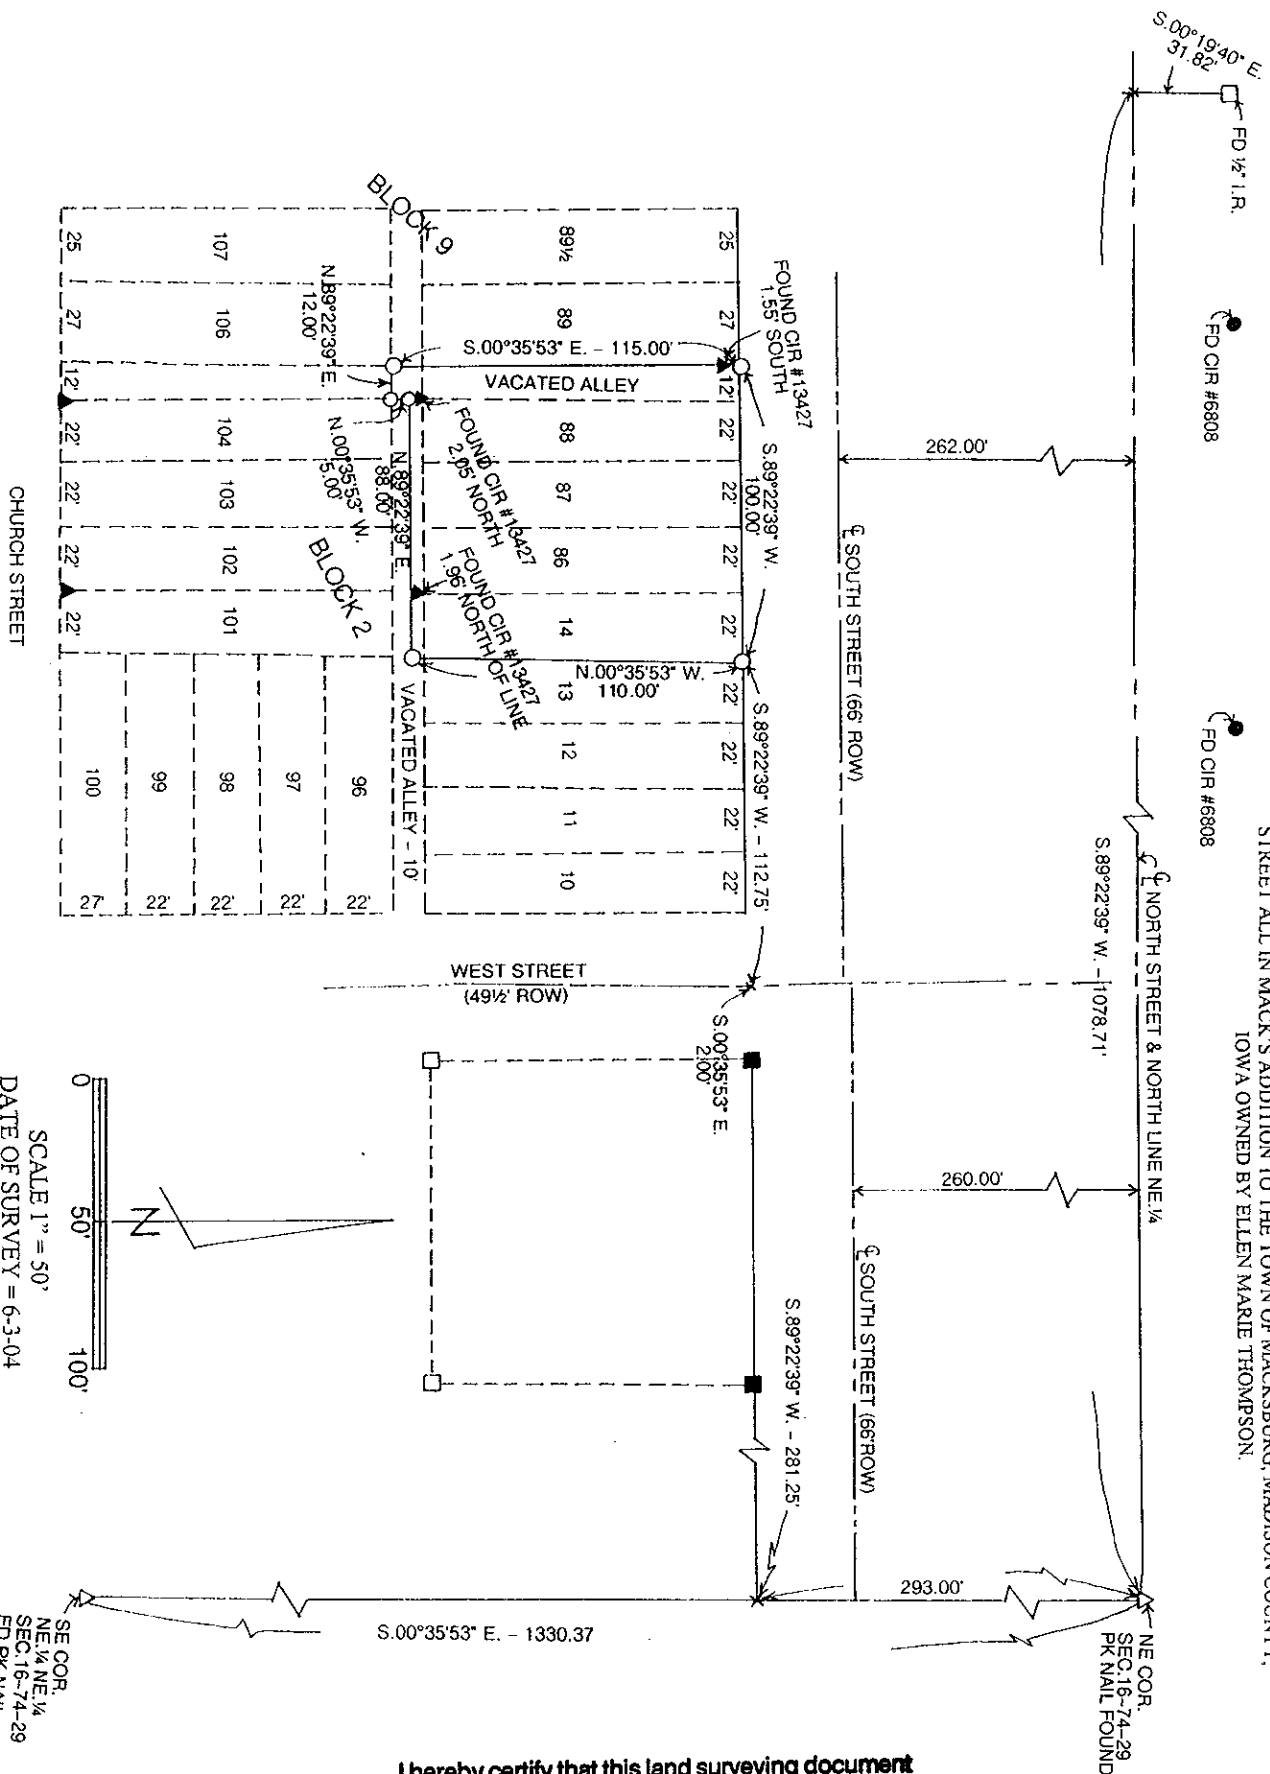

PLAT OF SURVEY LOTS 14, 86, 87, 88 AND THE NORTH 5 FEET OF THE WEST 88 FEET OF A VACATED ALLEY ALL IN BLOCK 2, AND A VACATED ALLEY BETWEEN BLOCK 2 & BLOCK 9 FROM THE NORTHWEST CORNER OF LOT 104, BLOCK 2 TO THE SOUTH LINE OF SOUTH STREET ALL IN MACK'S ADDITION TO THE TOWN OF MACKSBURG, MADISON COUNTY, IOWA OWNED BY ELLEN MARIE THOMPSON.

- CAPPED IRON ROD (CIR) #6808 SET
- CIR # 6808 FOUND
- CIR # 7995 FOUND
- 1/2" IRON ROD FOUND
- ▲ CIR # 13427 FOUND
- △ P.K. NAIL FOUND

SCALE 1" = 50'
DATE OF SURVEY = 6-3-04

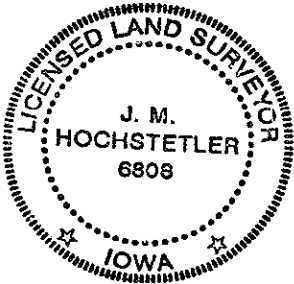

I hereby certify that this land surveying document was prepared and the related survey work was performed by me or under my direct personal supervision and that I am a duly licensed Land Surveyor under the laws of the State of Iowa.
J.M. Hochstetler
J.M. HOCHSTETLER
License number 6808 Date 6/23/04
My license renewal date is December 31, 2005
Pages or sheets covered by this seal: 1