Document 2004 3593

Book 2004 Page 3593 Type 06 43 Pages 1
Date 8/02/2004 Time 3:39 PM
Rec Amt $7.00

COMPUTER ✓
RECORDED ✓
COMPARED

MICHELLE "MICKI" UTSLER, COUNTY RECORDER
MADISON IOWA

04-555
04-555 waffle

VANCE & HOCHSTETLER, P.C., CONSULTING ENGINEERS, WINTERSET, IOWA (515) 462-3995
CHARLES T. VANCE, 110 West Green St., Winterset, Iowa, 50273
JAMES M HOCHSTETLER, 110 West Green St., Winterset, Iowa 50273

UNITED STATES PUBLIC LAND SURVEY CORNER CERTIFICATE

OF

Land Survey Monuments situated in Section 32, Township 76 N, Range 26 W, of the Fifth Principal Meridian, MADISON County, Iowa.
Previously recorded in _____ (book, page, document number, etc.) in County Recorder's Office.

(Show reason for preparing this certificate, the evidence and detailed procedures used in establishing the the corner positions and monumentation found or placed.)


Monument Description and Remarks: Center - Set yellow CIR #6808 (exposed) at old 4 Way Property line fence intersection

SW Cor NW¼ SW¼ - Set yellow CIR #6808 (4" Deep) at midpoint on line between found W¼ Cor and SW Cor. of Section. SE COR NW¼ SW¼ - Set yellow CIR #6808 (exposed) at midpoint on line between set SW COR NW¼ SW¼ & Set SE COR NE¼ SW¼.

SE COR NE¼ SW¼ - Set yellow CIR #6808 (exposed) at mid point on line between set Center of Section and found S¼ Cor.

PLAN - VIEW

(Show a minimum of three reference ties to durable physical objects, relevant monuments and physical conditions that will enable recovery of the corner.)

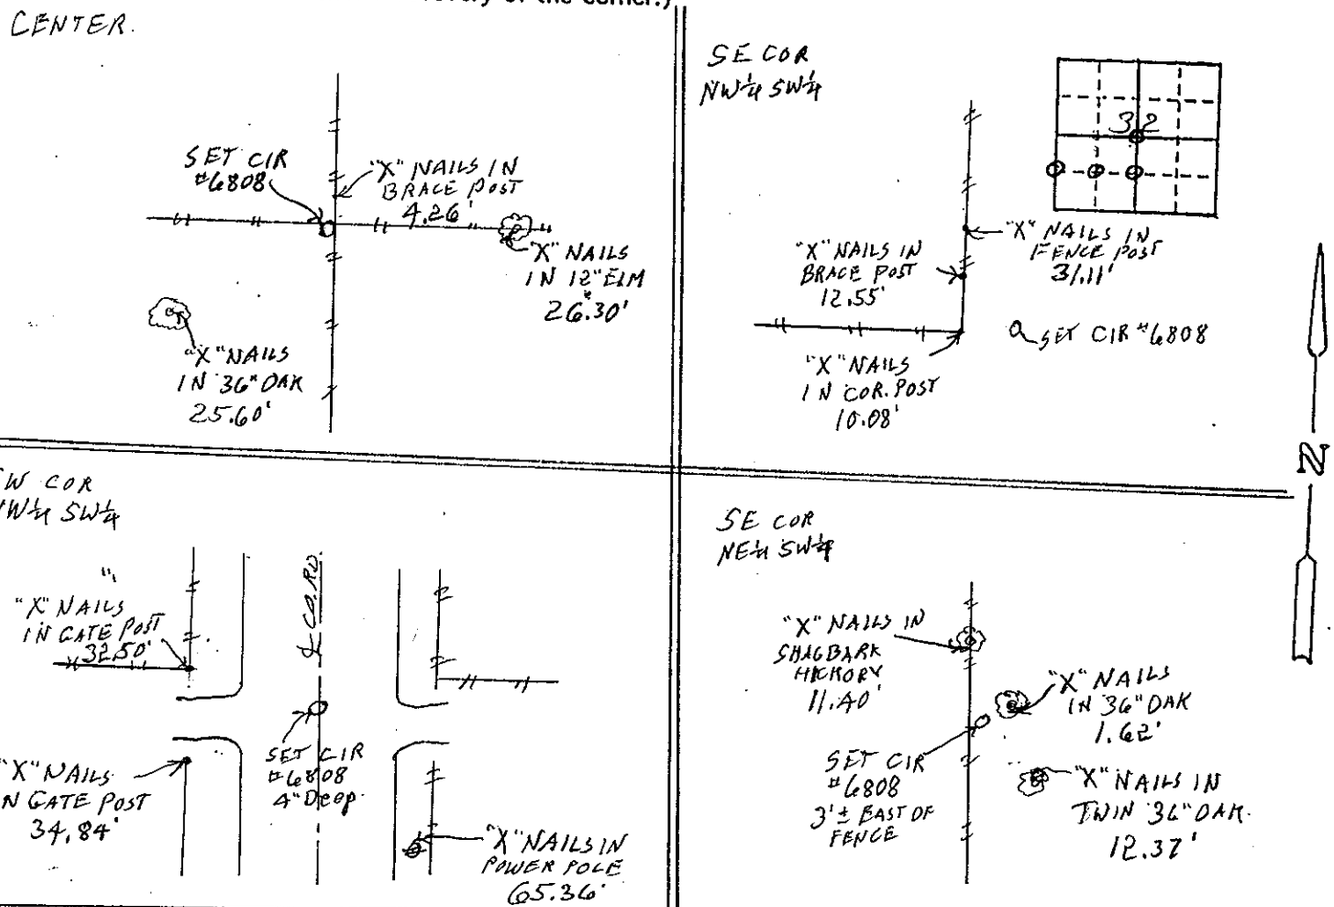

LICENSED LAND SURVEYOR
J. M. HOCHSTETLER
6808
IOWA

I hereby certify that this land surveying document was prepared and the related survey work was performed by me or under my direct personal supervision and that I am a duly licensed Land Surveyor under the laws of the State of Iowa.

J.M. HOCHSTETLER
License number 6808 Date 5/10/04
My license renewal date is December 31, 2005
Pages or sheets covered by this seal: 1

List Corners to be Indexed

Corners	Section	Twp	Range
CENTER	32	76N	26W
SW COR. NW¼ SW¼	32	76N	26W
SE COR NW¼ SW¼	32	76N	26W
SE COR NE¼ SW¼	32	76N	26W