Document 2004 4520

Book 2004 Page 4520 Type 06 43 Pages 1
Date 9/24/2004 Time 1:38 PM
Rec Amt $7.00

COMPUTER ✓
RECORDED ✓
COMPARED ____

MICHELLE "MICKI" UTSLER, COUNTY RECORDER
MADISON IOWA

RETURN TO: BOLDMAN LAND SURVEYING, P.C., BOX 66, WINTERSET, IA 50273 515-462-9242

UNITED STATES PUBLIC LAND SURVEY CORNER CERTIFICATE OF


Land Survey Monuments situated in Section 20, Township 74 N, Range 26 W, of the Fifth Principal Meridian, Madison County, Iowa
Previously recorded in None found in County Recorder's Office.
(book, page, document number, etc.)

(show reason for preparing this certificate, the evidence and detailed procedures used in establishing the corner positions and monumentation found or placed.)

Monument Description and Remarks: Land corners were set using information from County Engineer plans.

PLAN-VIEW

(Show a minimum of three reference ties to durable physical objects, relevant monuments and physical conditions that will enable recovery of the corner.)

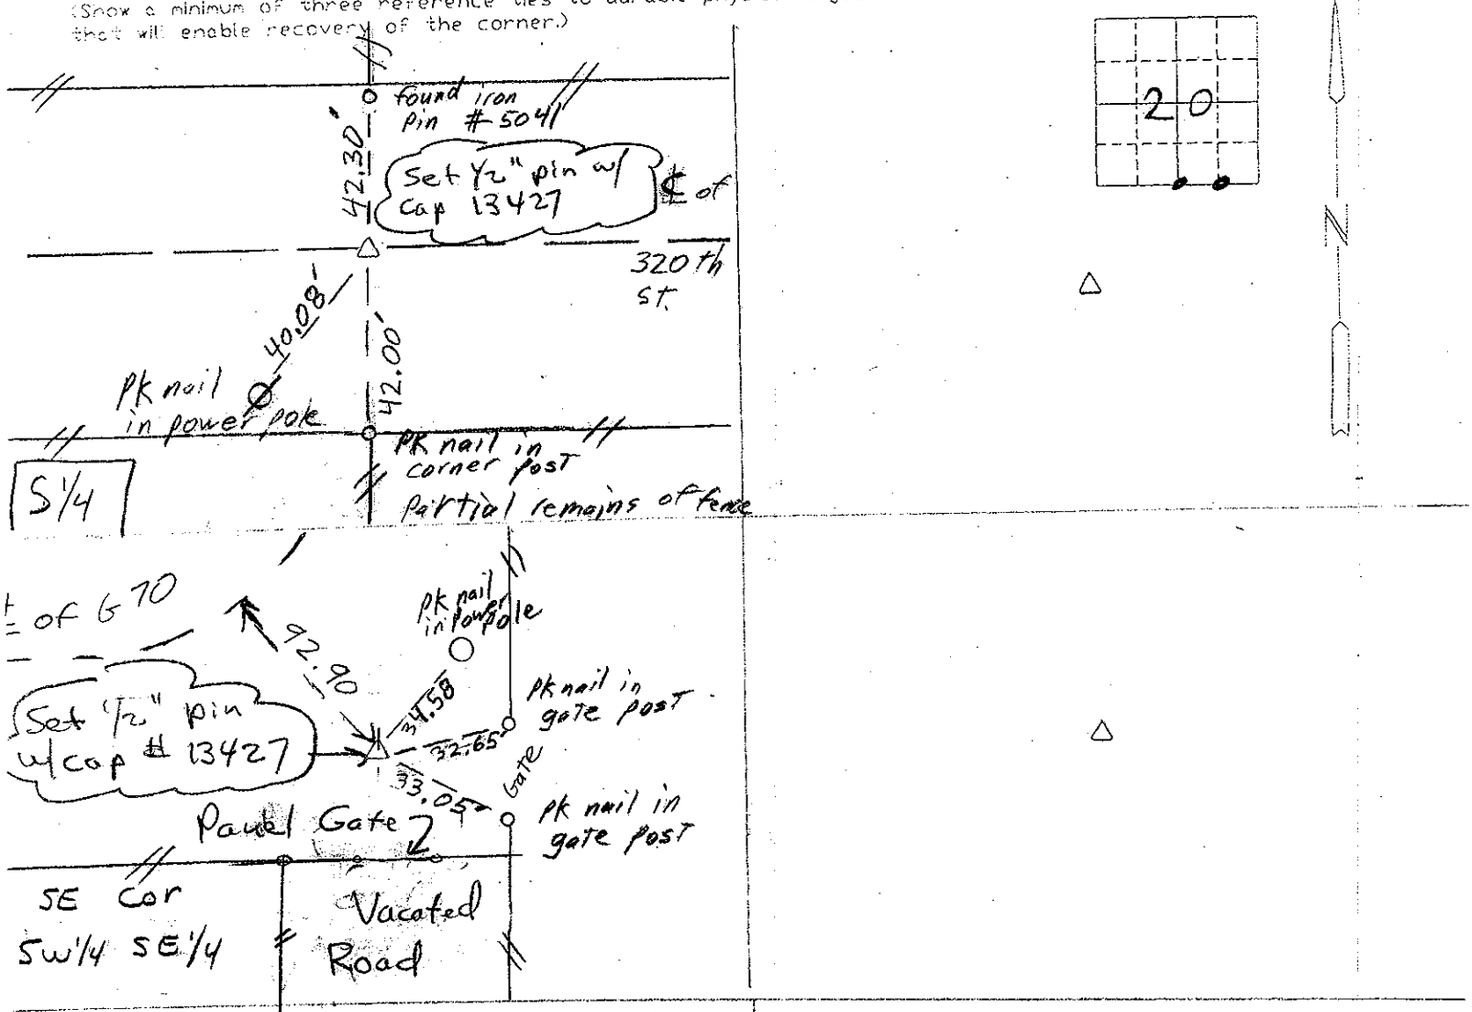

I hereby certify that the survey work was completed and this certificate was prepared by me or under my direct personal supervision and that I am a duly licensed Land Surveyor under the laws of the State of Iowa

Signature: Craig S. Boldman

Date: 9/23/04 Reg. No. 13427

SEAL

LICENSED LAND SURVEYOR
CRAIG S. BOLDMAN
13427
IOWA

List Corners to be Indexed

Corners	Section	Twp	Range
S1/4	20	74	26
SE cor SW1/4 SE1/4	"	"	"

04068