Document 2004 5568

Book 2004 Page 5568 Type 06 43 Pages 1
Date 11/24/2004 Time 3:15 PM
Rec Amt $7.00

COMPUTER ✓
RECORDED ✓
COMPARED

MICHELLE "MICKI" UTSLER, COUNTY RECORDER
MADISON IOWA

VANCE & HOCHSTETLER,P.C. CONSULTING ENGINEERS, WINTERSET, IOWA (515)462-3995
CHARLES T. VANCE, 110 WEST GREEN ST.,WINTERSET, IOWA 50273
JAMES M. HOCHSTETLER, 110 WEST GREEN ST., WINTERSET, IOWA 50273

03-276 s

UNITED STATES PUBLIC LAND SURVEY CORNER CERTIFICATE

OF


Land Survey Monuments situated in Section 11, Township 76 North, Range 28 West, of the Fifth Principal Meridian, Madison County, Iowa.
Previously recorded in N/A in County Recorder's Office.
(book, page, document number, etc.)

(Show reason for preparing this certificate, the evidence and detailed procedures used in establishing the corner positions and monumentation found or placed.)


Monument Description and Remarks: Set Capped Iron Rod on NW. Cor. of NE¼ NW¼ at the projected intersection of a fence from the North and a fence from the West.
Set Capped Iron Rod on SW. Cor. of NE¼ NW¼ at the projected intersection of a fence from the East and a fence from the South

PLAN - VIEW

(Show a minimum of three reference ties to durable physical objects, relevant monuments and physical conditions that will enable recovery of the corner.)

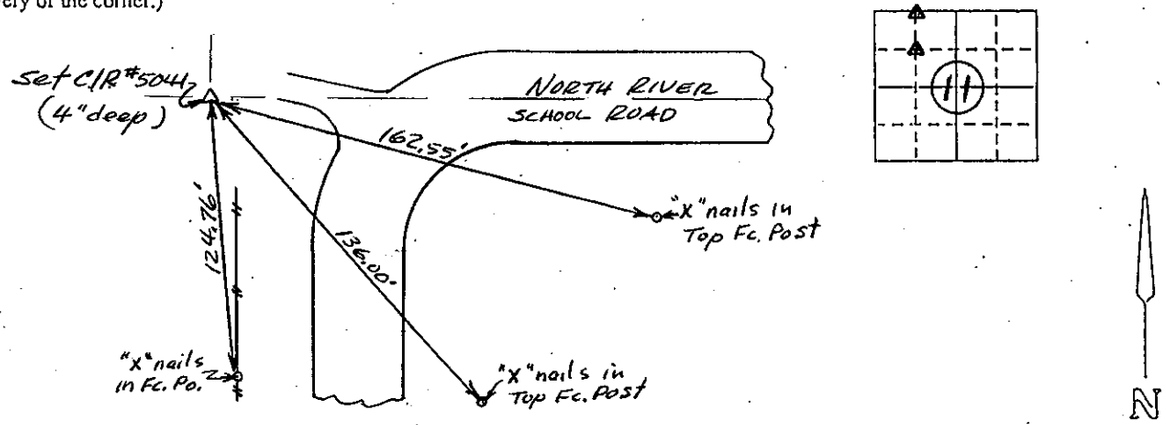

Ref. to NW. Cor. NE.¼ NW.¼ SEC. 11-T76N-R28W.

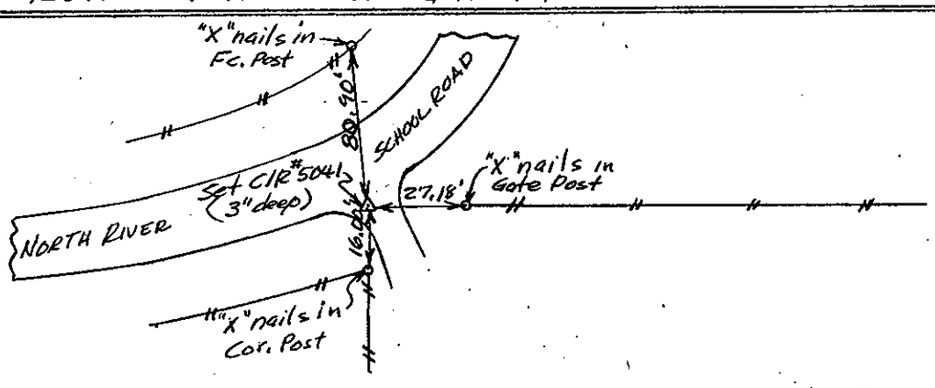

Ref. to SW. Cor. NE.¼ NW.¼ SEC. 11-T76N-R28W.

I hereby certify that the survey work was completed and this land surveying document was prepared by me or under my direct personal supervision and that I am a duly registered land surveyor under the laws of the state of Iowa

Signature: Charles T Vance
Name typed or printed: Charles T. Vance, PE & LS

Date: 27 Oct. 2004 Reg. No. 5041

My registration renewal date is December 31, 2005

PROFESSIONAL ENGINEER LICENSED CHARLES T. VANCE 5041 IOWA LAND SURVEYOR

List Corners to be Indexed

Corners	Section	Twp	Range
NW. Cor. NE.¼ NW¼	11	T76N	R28W
SW. Cor. NE.¼ NW¼	11	T76N	R28W