Document 2004 5231

Book 2004 Page 5231 Type 06 43 Pages 1
Date 11/04/2004 Time 2:08 PM
Rec Amt $7.00

MICHELLE "MICKI" UTSLER, COUNTY RECORDER
MADISON IOWA

RETURN TO : BOLDMAN LAND SURVEYING, P.C., BOX 66, WINTERSET, IA 50273 515-462-9242

UNITED STATES PUBLIC LAND SURVEY CORNER CERTIFICATE

OF

COMPUTER ✓
RECORDED ✓
COMPARED
Range


Land Survey Monuments situated in Section 33, Township 74, 27, of the Fifth Principal Meridian, Madison County, Iowa
Previously recorded in None found In County Recorder's Office.
(book, page, document number, etc.)

(show reason for preparing this certificate, the evidence and detailed procedures used in establishing the corner positions and monumentation found or placed.)

Monument Description and Remarks: SW cor- set ip at old fence cor post
NW Cor SW1/4 SW1/4 - set ip halfway betn SW & W1/4. NE cor. SW1/4 SW1/4 - set ip at calc'd corner. SE cor SW1/4 SW1/4 - set ip at old corner post

PLAN-VIEW

(Show a minimum of three reference tles to durable physical objects, relevant monuments and physical conditions that will enable recovery of the corner.)

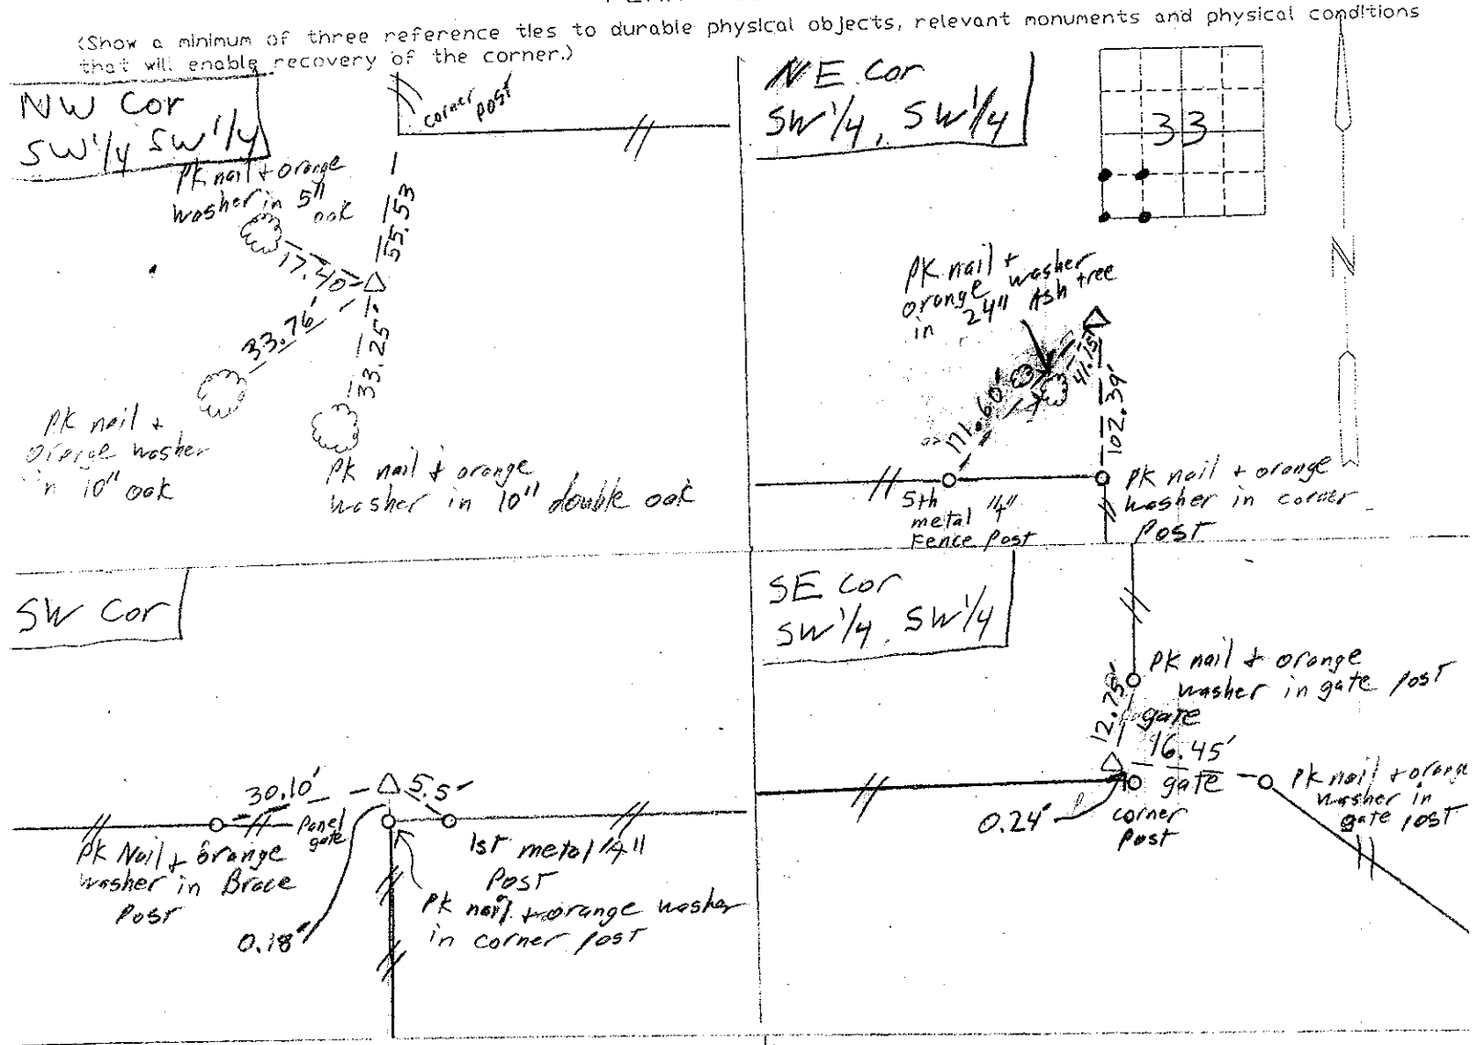

I hereby certify that the survey work was completed and this certificate was prepared by me or under my direct personal supervision and that I am a duly Licensed Land Surveyor under the laws of the State of Iowa

Signature: _____
Craig S. Boldman

Date: 11/4/04 Reg. No. 13427

SEAL

LICENSED LAND SURVEYOR
CRAIG S. BOLDMAN
13427
IOWA

List Corners to be Indexed

Corners	Section	Twp	Range
SW. Cor	33	74	27
NW cor SW1/4 SW1/4	"	"	"
NE cor SW1/4 SW1/4	"	"	"
SE cor SW1/4 SW1/4	"	"	"

04084