Document 2004 5474

Book 2004 Page 5474 Type 06 43 Pages 1
Date 11/19/2004 Time 11:03 AM
Rec Amt $7.00

COMPUTER ✓
RECORDED ✓
COMPARED

MICHELLE "MICKI" UTSLER, COUNTY RECORDER
MADISON IOWA

RETURN TO: BOLDMAN LAND SURVEYING, P.C., BOX 66, WINTERSET, IA 50273 515-462-9242

UNITED STATES PUBLIC LAND SURVEY CORNER CERTIFICATE

OF


Land Survey Monuments situated in Section 18, Township 74, Range 27, of the Fifth Principal Meridian, Madison County, Iowa
Previously recorded in _____ in County Recorder's Office.
(book, page, document number, etc.)

(Show reason for preparing this certificate, the evidence and detailed procedures used in establishing the corner positions and monumentation found or placed.)

Monument Description and Remarks: N 1/4 Cor set at 4-way fence corner N W cor NE¼ NE¼ set halfway between N 1/4 + NE Cor NE Cor set on bearing of east-west fence, in line with north south fence on north side of road.

PLAN-VIEW

(Show a minimum of three reference ties to durable physical objects, relevant monuments and physical conditions that will enable recovery of the corner.)

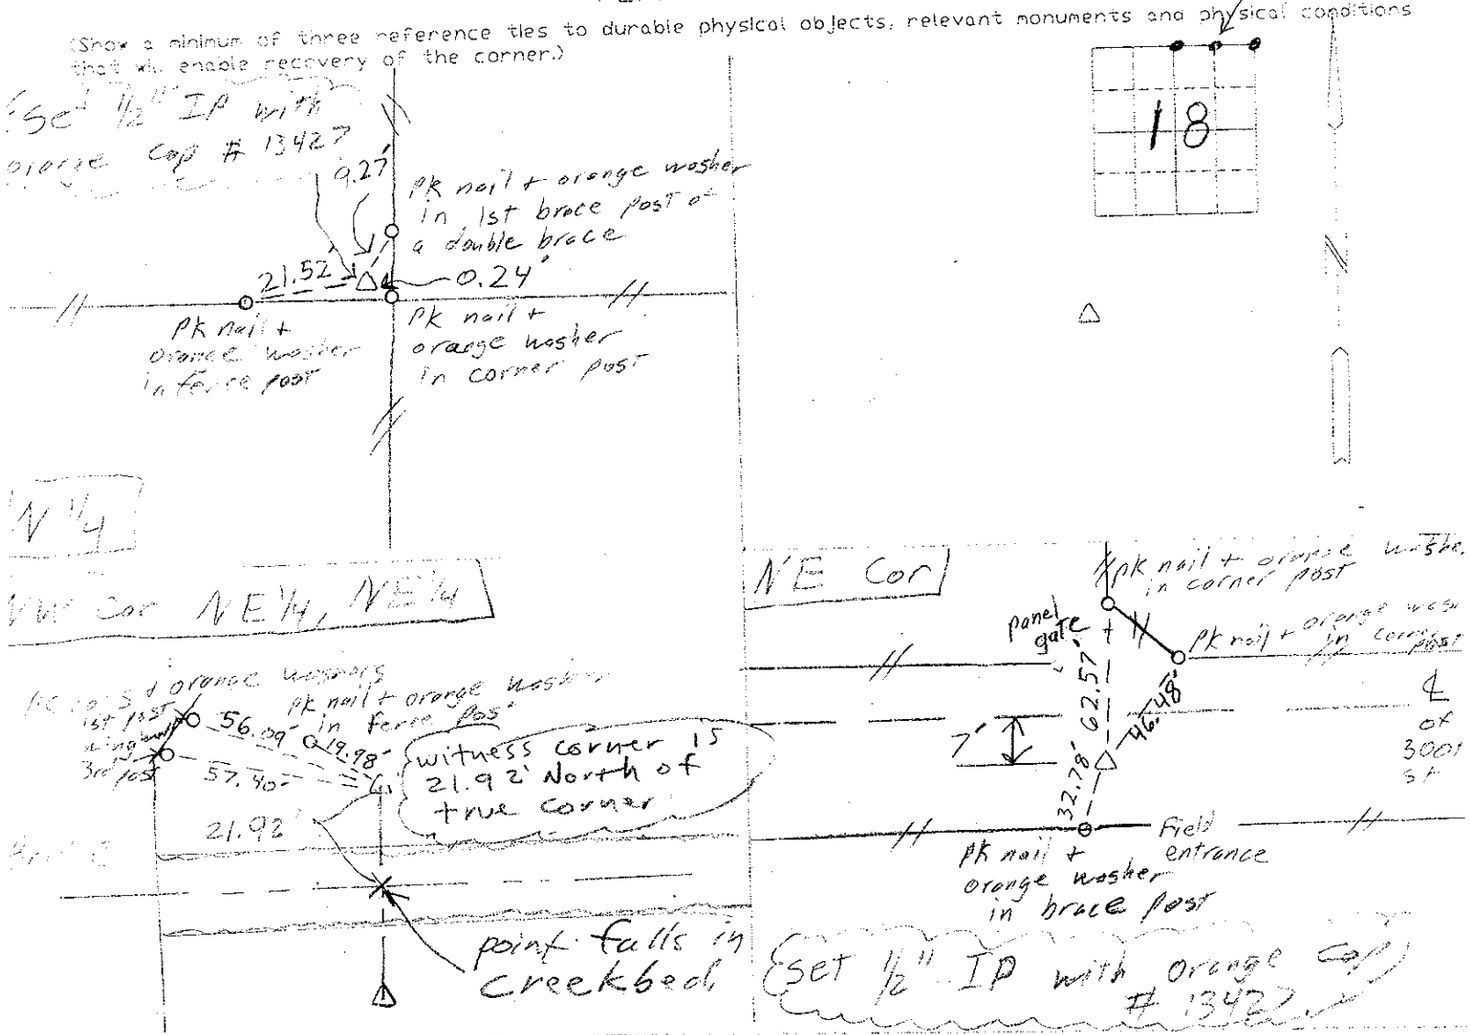

I hereby certify that the survey work was completed and this certificate was prepared by me or under my direct personal supervision and that I am a duly Licensed Land Surveyor under the laws of the State of Iowa

Signature: _____
Craig S. Boldman

Date: 11/16/04 Reg. No. 13427

SEAL

LICENSED LAND SURVEYOR
CRAIG S. BOLDMAN
13427
IOWA

List Corners to be Indexed

Corners	Section	Twp	Range
N 1/4	18	74	27
NE cor	18	74	27
¼ NW cor NE¼ NE¼	18	74	27

04084