Document 2004 5749
Book 2004 Page 5749 Type 06 43 Pages 1
Date 12/06/2004 Time 3:54 PM
Rec Amt $7.00

MICHELLE "MICKI" UTSLER, COUNTY RECORDER
MADISON IOWA

VANCE & HOCHSTETLER,P.C. CONSULTING ENGINEERS, WINTERSET, IOWA (515)462-3995
03-2635 CHARLES T. VANCE, 110 WEST GREEN ST.,WINTERSET, IOWA 50273
JAMES M. HOCHSTETLER, 110 WEST GREEN ST., WINTERSET, IOWA 50273

COMPUTER ✓
RECORDED ✓
COMPARED

UNITED STATES PUBLIC LAND SURVEY CORNER CERTIFICATE

OF

Land Survey Monuments situated in Section 25, Township 77 North, Range 28 West, of the Fifth Principal Meridian, Madison County, Iowa.
Previously recorded in N/A (book, page, document number, etc.) in County Recorder's Office.


(Show reason for preparing this certificate, the evidence and detailed procedures used in establishing the corner positions and monumentation found or placed.)

Monument Description and Remarks: Set NE. Cor. of the SW.¼ SE.¼ on line between the NE.Cor. of SE.¼ SE.¼ and the NW.Cor. of SW.¼ SE.¼, and in line with a fence to the south.


Set SE.Cor. of the SW.¼ SE.¼ at the intersection of an east-west fence and a fence to the north.

PLAN - VIEW

(Show a minimum of three reference ties to durable physical objects, relevant monuments and physical conditions that will enable recovery of the corner.)

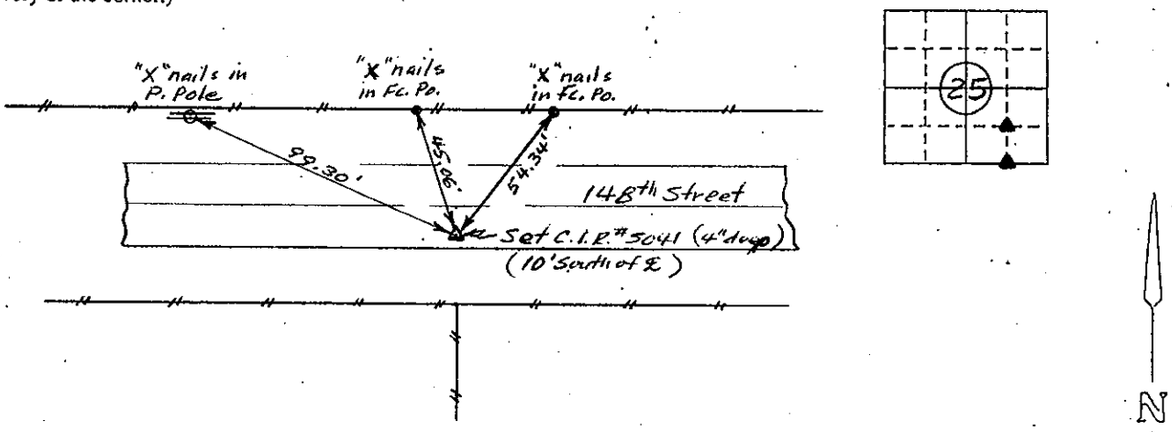

Ref. to NE.Cor. SW¼ of SE.¼ of Section 25-T77N-R28W

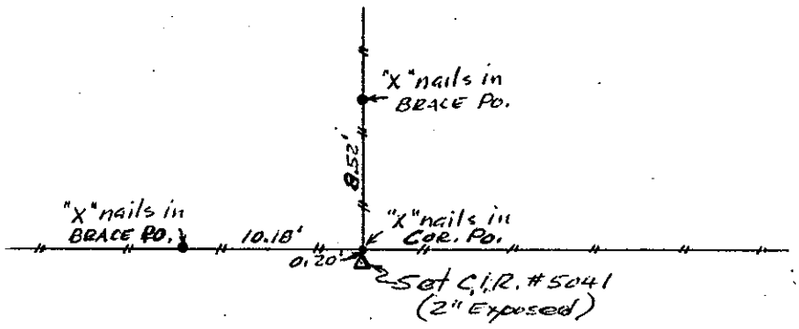

Ref. to SE. Coe. SW¼ of SE.¼ of Section 25-T77N-R28W

I hereby certify that the survey work was completed and this land surveying document was prepared by me or under my direct personal supervision and that I am a duly registered land surveyor under the laws of the state of Iowa

Signature: Charles T Vance
Name typed or printed: Charles T. Vance, PE & LS

Date: 1 Dec. 2004 Reg. No. 5041

My registration renewal date is December 31, 2005

PROFESSIONAL ENGINEER LICENSED CHARLES T. VANCE 5041 IOWA LAND SURVEYOR

List Corners to be Indexed

Corners	Section	Twp	Range
NE.Cor. SW¼ SE¼	25-	T77N-	R28W
SE. Cor. SW¼ SE¼	25-	T77N-	R28W.