Document 2004 5788

Book 2004 Page 5788 Type 06 43 Pages 1
Date 12/08/2004 Time 12:43 PM
Rec Amt $7.00

COMPUTER ✓
RECORDED ✓
COMPARED

MICHELLE "MICKI" UTSLER, COUNTY RECORDER
MADISON IOWA

Prepared By: J. Brian Morrissey, Morrissey Surveying, 1405 HIGHWAY G28, OTLEY, IA 50214, Tel. (641) 627-5554

UNITED STATES PUBLIC LAND SURVEY CORNER CERTIFICATE OF

Land Survey Monuments situated in Section 13, Township 76 N, Range 28 W, of the Fifth Principal Meridian, Madison County, Iowa.
Previously recorded in _____ in County Recorders Office.


(book, page, document number, etc.)


(Show reason for preparing this certificate, the evidence and detailed procedures used in establishing the corner positions and monumentation found or placed.)

Monument Description and Remarks: Set 5/8" x 18" rebar with orange plastic cap, #7995. Corner position calculated from information gathered while traversing the Southwest Quarter of Section and from previous survey of all of Section 14.

PLAN VIEW

(Show a minimum of three reference ties to durable physical objects, relevant monuments and physical conditions that will enable recovery of the corner.)

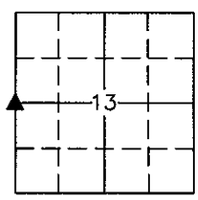

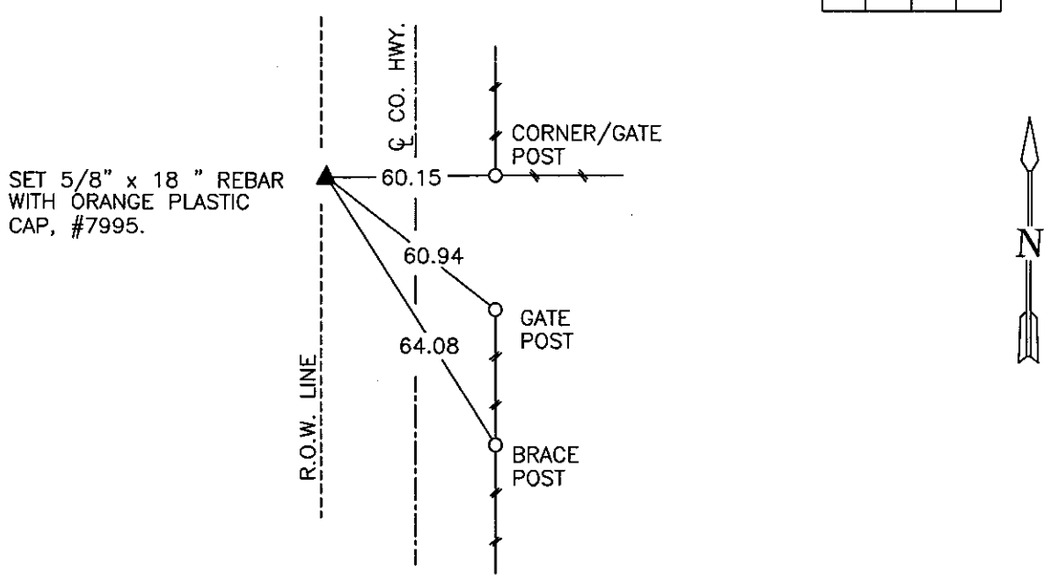

NE. COR., SW. 1/4., SEC. 13

NOTE: ALL TIES TO "X" NAILS UNLESS NOTED.

PROFESSIONAL ENGINEER & LAND SURVEYOR
J.BRIAN MORRISSEY 7995
LICENSED ☆ IOWA ☆

I hereby certify that the survey work was completed and this certificate was prepared by me or under my direct personal supervision and that I am a duly Licensed Land Surveyor under the laws of the State of Iowa.

Signature: J. Brian Morrissey Date: 11/30/04
J. Brian Morrissey

License number 7995.
My license renewal date is December 31, 2005.

458-04-5