Document 2004 5854

Book 2004 Page 5854 Type 06 43 Pages 1
Date 12/13/2004 Time 12:17 PM
Rec Amt $7.00

MICHELLE "MICKI" UTSLER, COUNTY RECORDER
MADISON IOWA

VANCE & HOCHSTETLER, P.C., CONSULTING ENGINEERS, WINTERSET, IOWA (515) 462-3995
03-2855 CHARLES T. VANCE, 110 West Green St., Winterset, Iowa, 50273
JAMES M HOCHSTETLER, 110 West Green St., Winterset, Iowa 50273

COMPUTER ✓
RECORDED ✓
COMPARED

UNITED STATES PUBLIC LAND SURVEY CORNER CERTIFICATE

OF


Land Survey Monuments situated in Section 8, Township 76N, Range 27W, of the Fifth Principal Meridian, MADISON County, Iowa.
Previously recorded in _____ (book, page, document number, etc.) in County Recorder's Office.


(Show reason for preparing this certificate, the evidence and detailed procedures used in establishing the the corner positions and monumentation found or placed.)


Monument Description and Remarks: N.E.Cor NW¼ NW¼ - Set yellow CIR #6808 at intersection of property line fence from West and South.
SE COR NW¼ NW¼ - Set yellow CIR #6808, 4" Deep at mid point on line between Set NE Cor NW¼ NW¼ and Set SE COR SW¼ NW¼.
SE Cor SW¼ NW¼ - Set yellow CIR #6808, 4" Deep at centerline of County Road in line with property line fence West.

PLAN - VIEW

(Show a minimum of three reference ties to durable physical objects, relevant monuments and physical conditions that will enable recovery of the corner.)

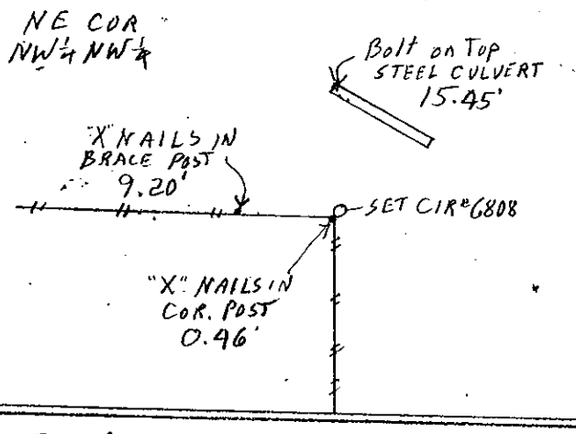

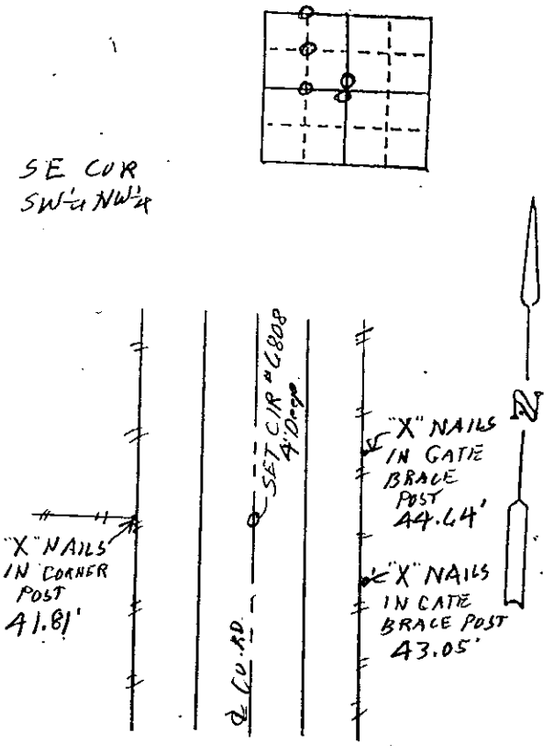

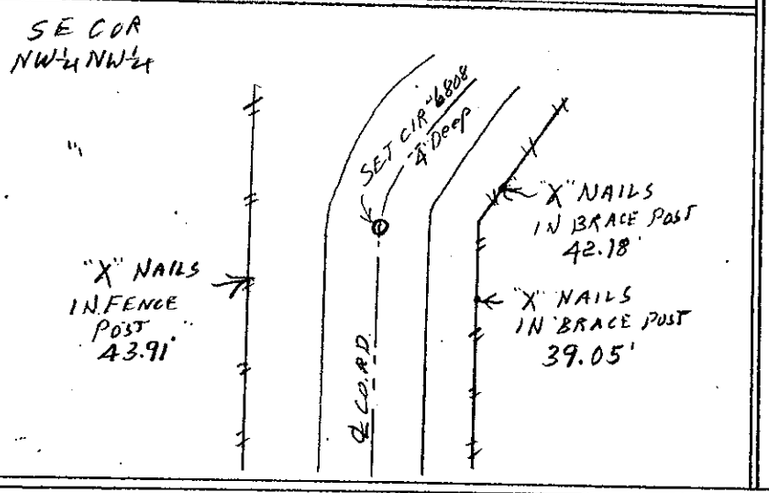

LICENSED LAND SURVEYOR
J. M. HOCHSTETLER
6808
IOWA

I hereby certify that this land surveying document was prepared and the related survey work was performed by me or under my direct personal supervision and that I am a duly licensed Land Surveyor under the laws of the State of Iowa.

J. M. Hochstetler
J.M. HOCHSTETLER
License number 6808 Date 11/24/04
My license renewal date is December 31, 2005
Pages or sheets covered by this seal: 1

List Corners to be Indexed

Corners	Section	Twp	Range
NE COR NW¼ NW¼	8	76N	27W
SE COR NW¼ NW¼	8	76N	27W
SE COR SW¼ NW¼	8	76N	27W