Document 2004 5855

Book 2004 Page 5855 Type 06 43 Pages 1
Date 12/13/2004 Time 12:18 PM
Rec Amt $7.00

MICHELLE "MICKI" UTSLER, COUNTY RECORDER
MADISON IOWA

VANCE & HOCHSTETLER, P.C., CONSULTING ENGINEERS, WINTERSET, IOWA (515) 462-3995
03-2855 CHARLES T. VANCE, 110 West Green St., Winterset, Iowa, 50273
JAMES M HOCHSTETLER, 110 West Green St., Winterset, Iowa 50273

COMPUTER ✓
RECORDED ✓
COMPARED

UNITED STATES PUBLIC LAND SURVEY CORNER CERTIFICATE OF


Land Survey Monuments situated in Section 7, Township 76 N, Range 27 W, of the Fifth Principal Meridian, MADISON County, Iowa.
Previously recorded in _____ (book, page, document number, etc.) in County Recorder's Office.


(Show reason for preparing this certificate, the evidence and detailed procedures used in establishing the the corner positions and monumentation found or placed.)


Monument Description and Remarks: SW Cor. NE¼NE¼ - Set yellow CIR #6808 at midpoint on line between found NW Cor NE¼NE¼ and Set SW Cor SE¼NE¼, SE Cor NE¼NE¼ - Set yellow CIR #6808 at midpoint on line between found NE cor and E¼ Cor. W¼ Cor - Set yellow CIR #6808 at intersection of old property line fences East, West and South. SW Cor SE¼NE¼ - Set yellow CIR #6808 at old property line fence corner.


PLAN - VIEW

(Show a minimum of three reference ties to durable physical objects, relevant monuments and physical conditions that will enable recovery of the corner.)

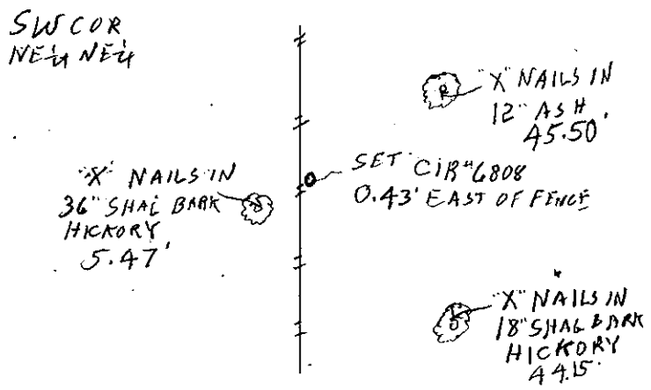

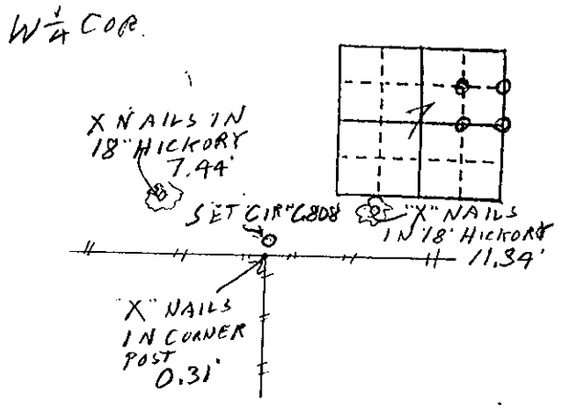

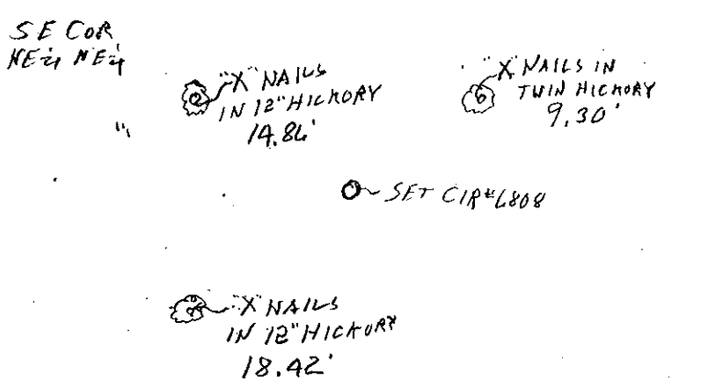

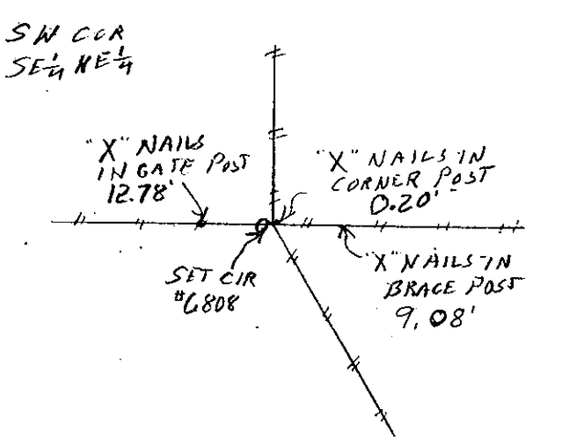

LICENSED LAND SURVEYOR J. M. HOCHSTETLER 6808 IOWA

I hereby certify that this land surveying document was prepared and the related survey work was performed by me or under my direct personal supervision and that I am a duly licensed Land Surveyor under the laws of the State of Iowa.

J.M. HOCHSTETLER
License number 6808 Date 11/24/04
My license renewal date is December 31 2005
Pages or sheets covered by this seal: 1

List Corners to be Indexed

Corners	Section	Twp	Range
SW COR NE¼ NE¼	7	76N	27W
SE. COR NE¼ NE¼	7	76N	27W
W¼ COR.	7	76N	27W
SW COR SE¼ NE¼	7	76N	27W