

MICHELLE "MICKI" UTSLER, COUNTY RECORDER  
MADISON IOWA



ABACI CONSULTING, 101 NORTH CIRCLE DR., GRIMES, IOWA 50111, PH(515)986-5048

# UNITED STATES PUBLIC LAND SURVEY CORNER CERTIFICATE

LAND SURVEY MONUMENTS SITUATED IN SECTION 18 of 76 TOWNSHIP, RANGE 29, of the Fifth Principal Meridian, Madison County, Iowa.

Monument Description & Remarks: Found PK nail in newer bridge deck, previous ties (Bk 1, PG 324) were obliterated, distance matched previously recorded distances to the 1/4, 1/4 corners South and East within 0.05' and 0.07 feet respectively. Nail was excepted: retied corner with "x" cuts in bridge deck.

## PLAN VIEW

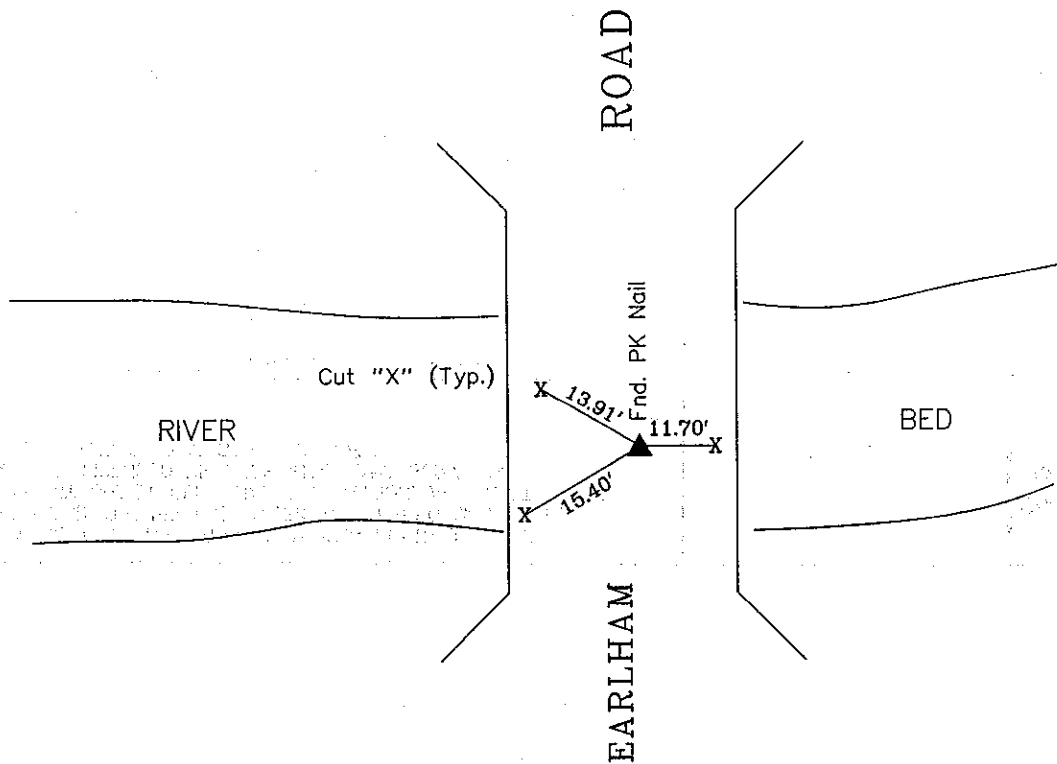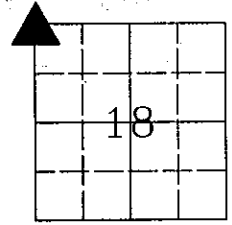

### NW Corner Sec 18-76-29


Fnd. PK nail in newer bridge deck, previous ties were obliterated, Retied corner with "x" cuts in bridge deck.

I HEREBY CERTIFY THAT THIS SURVEYING DOCUMENT WAS PREPARED AND THE RELATED WORK WAS PERFORMED BY ME OR UNDER MY DIRECT PERSONAL SUPERVISION, AND THAT I AM A DULY LICENSED PROFESSIONAL LAND SURVEYOR UNDER THE LAWS OF THE STATE OF IOWA.

*Mark A. McMurphy* 12-23-04  
MARK A. MCMURPHY, IOWA LIC. NO 14674 DATE

MY LICENSE RENEWAL DATE IS DECEMBER 31, 2004.

ADDITIONAL PAGES CERTIFIED (NONE UNLESS INDICATED HERE)

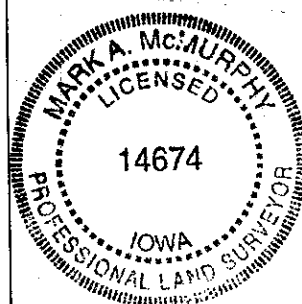

Corners to be Indexed:			
Corner	Section	Twp	Range
NW COR.	18	76	29